



TEL. 414-723-2098

MAP LEGEND

-
- MAP SCALE IN FEET

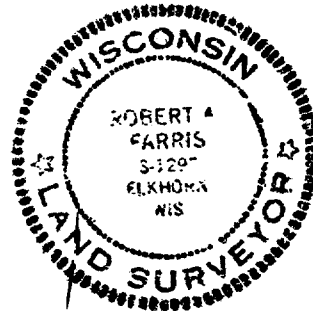

IRON PIPE FOUND IS
BENT WESTERLY. TOP
IS 0.4' WEST OF
LOT CORNER

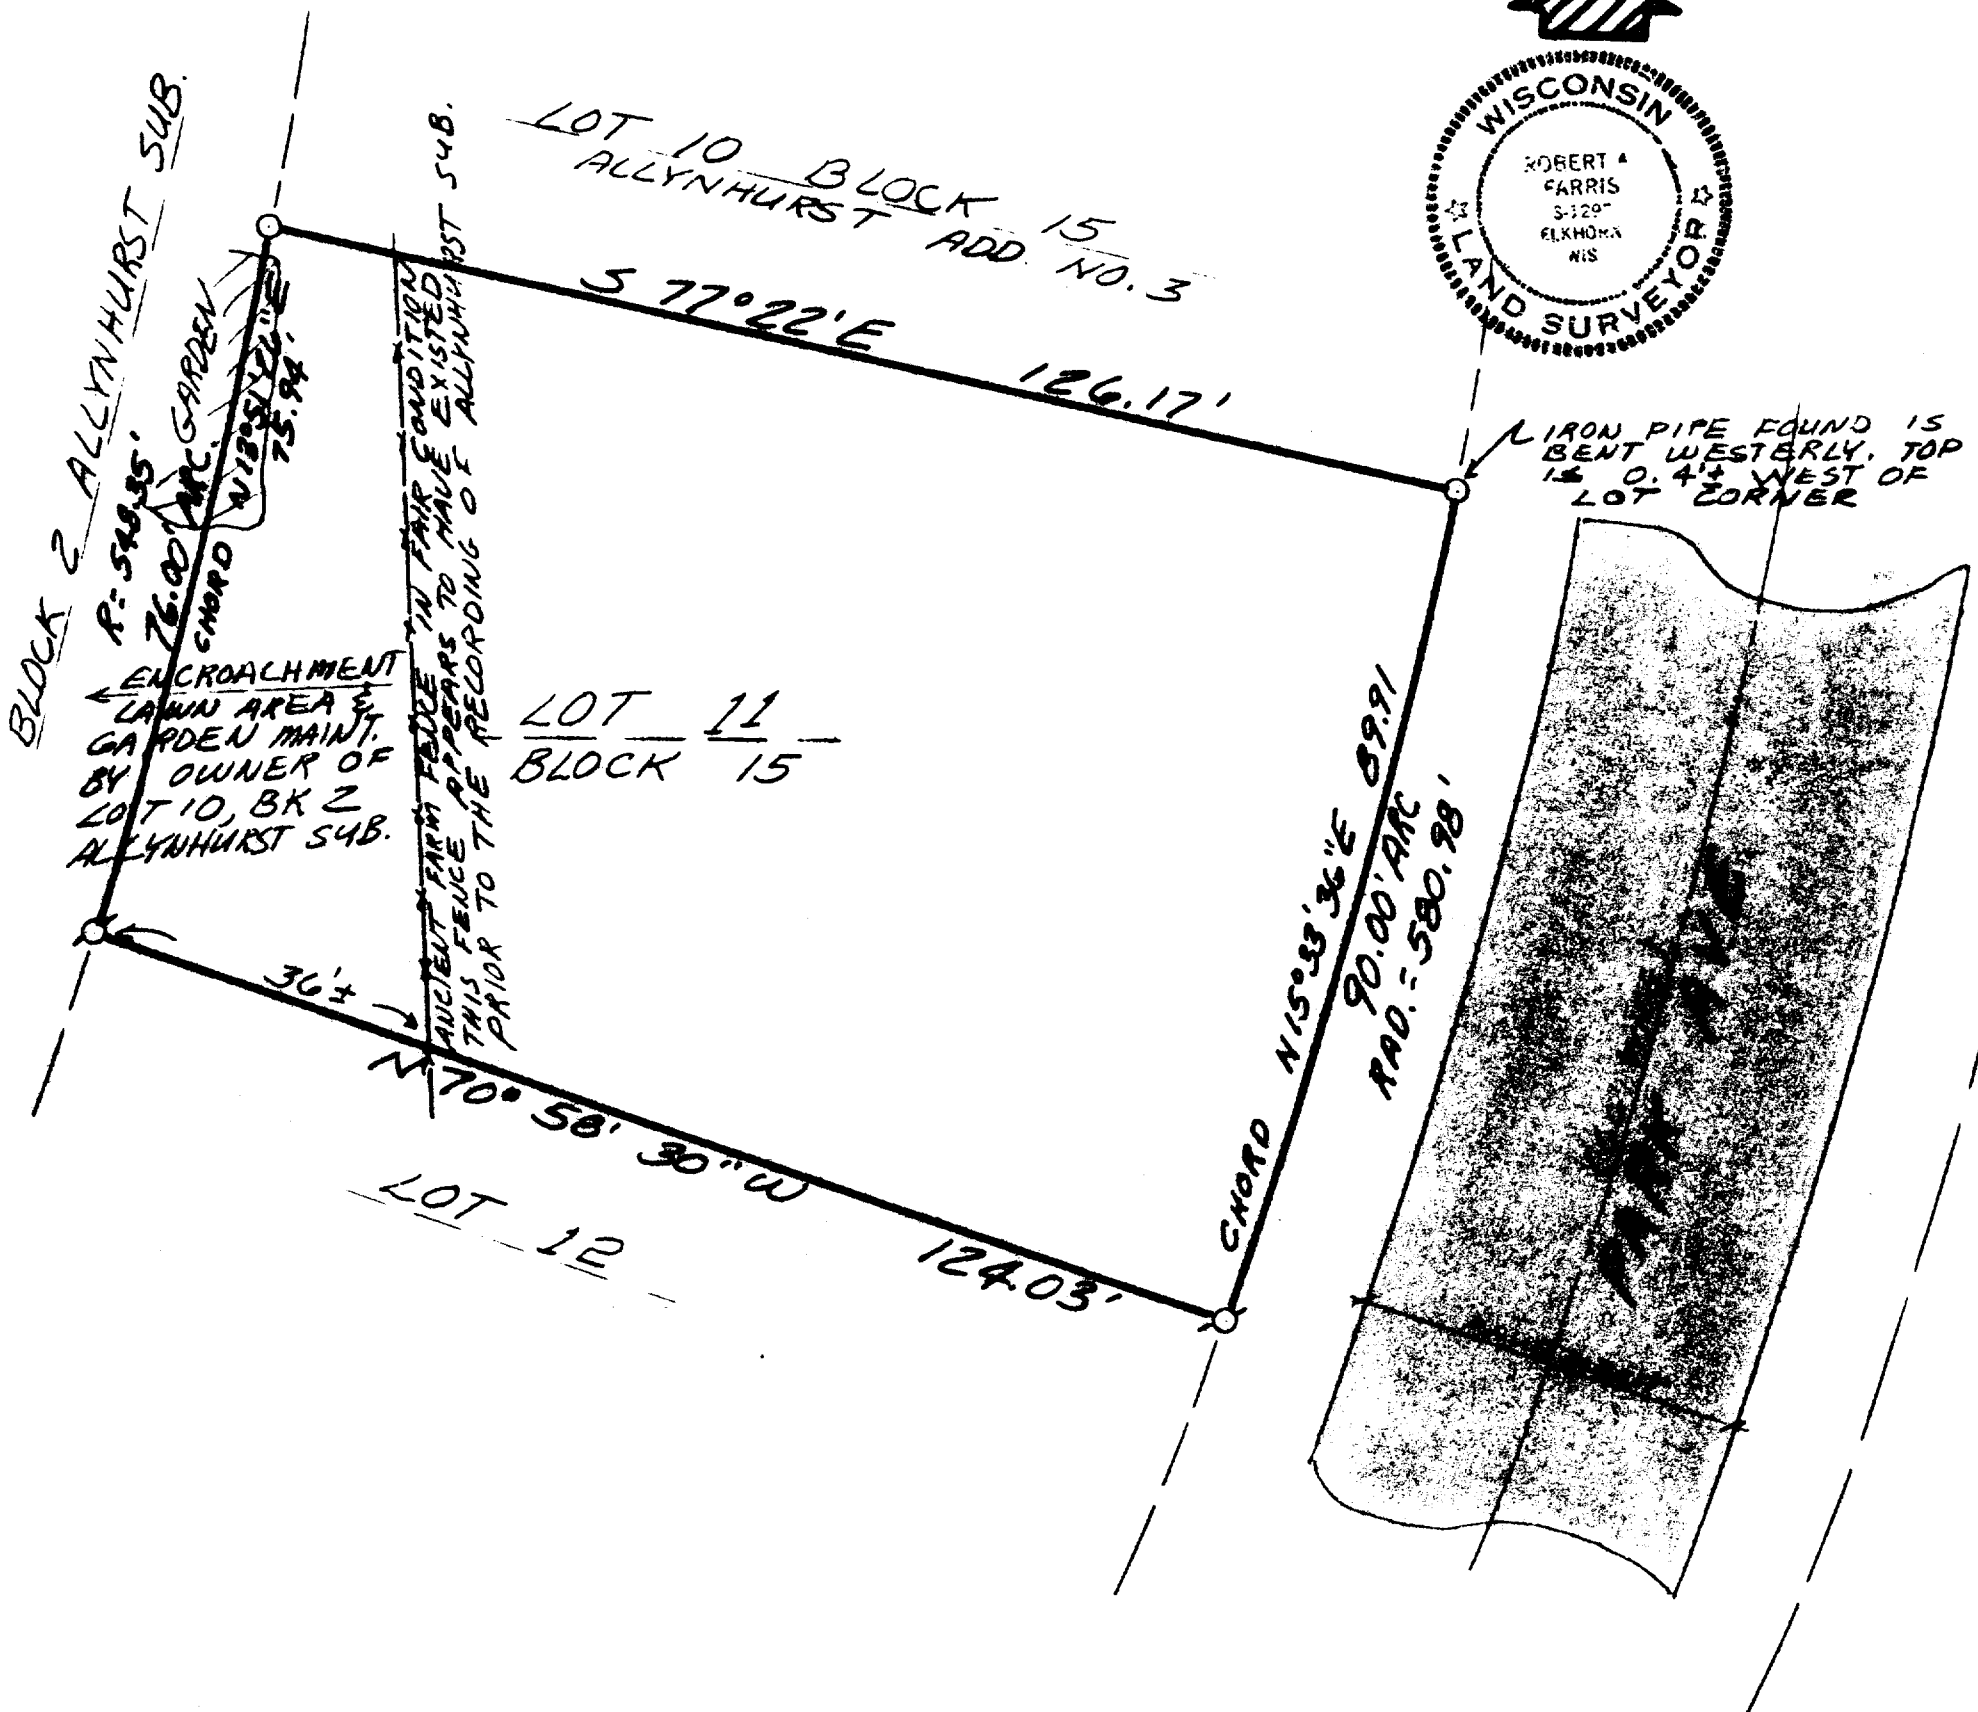

PROJ. 2933.B15.L11