


PHOENIX

STREET

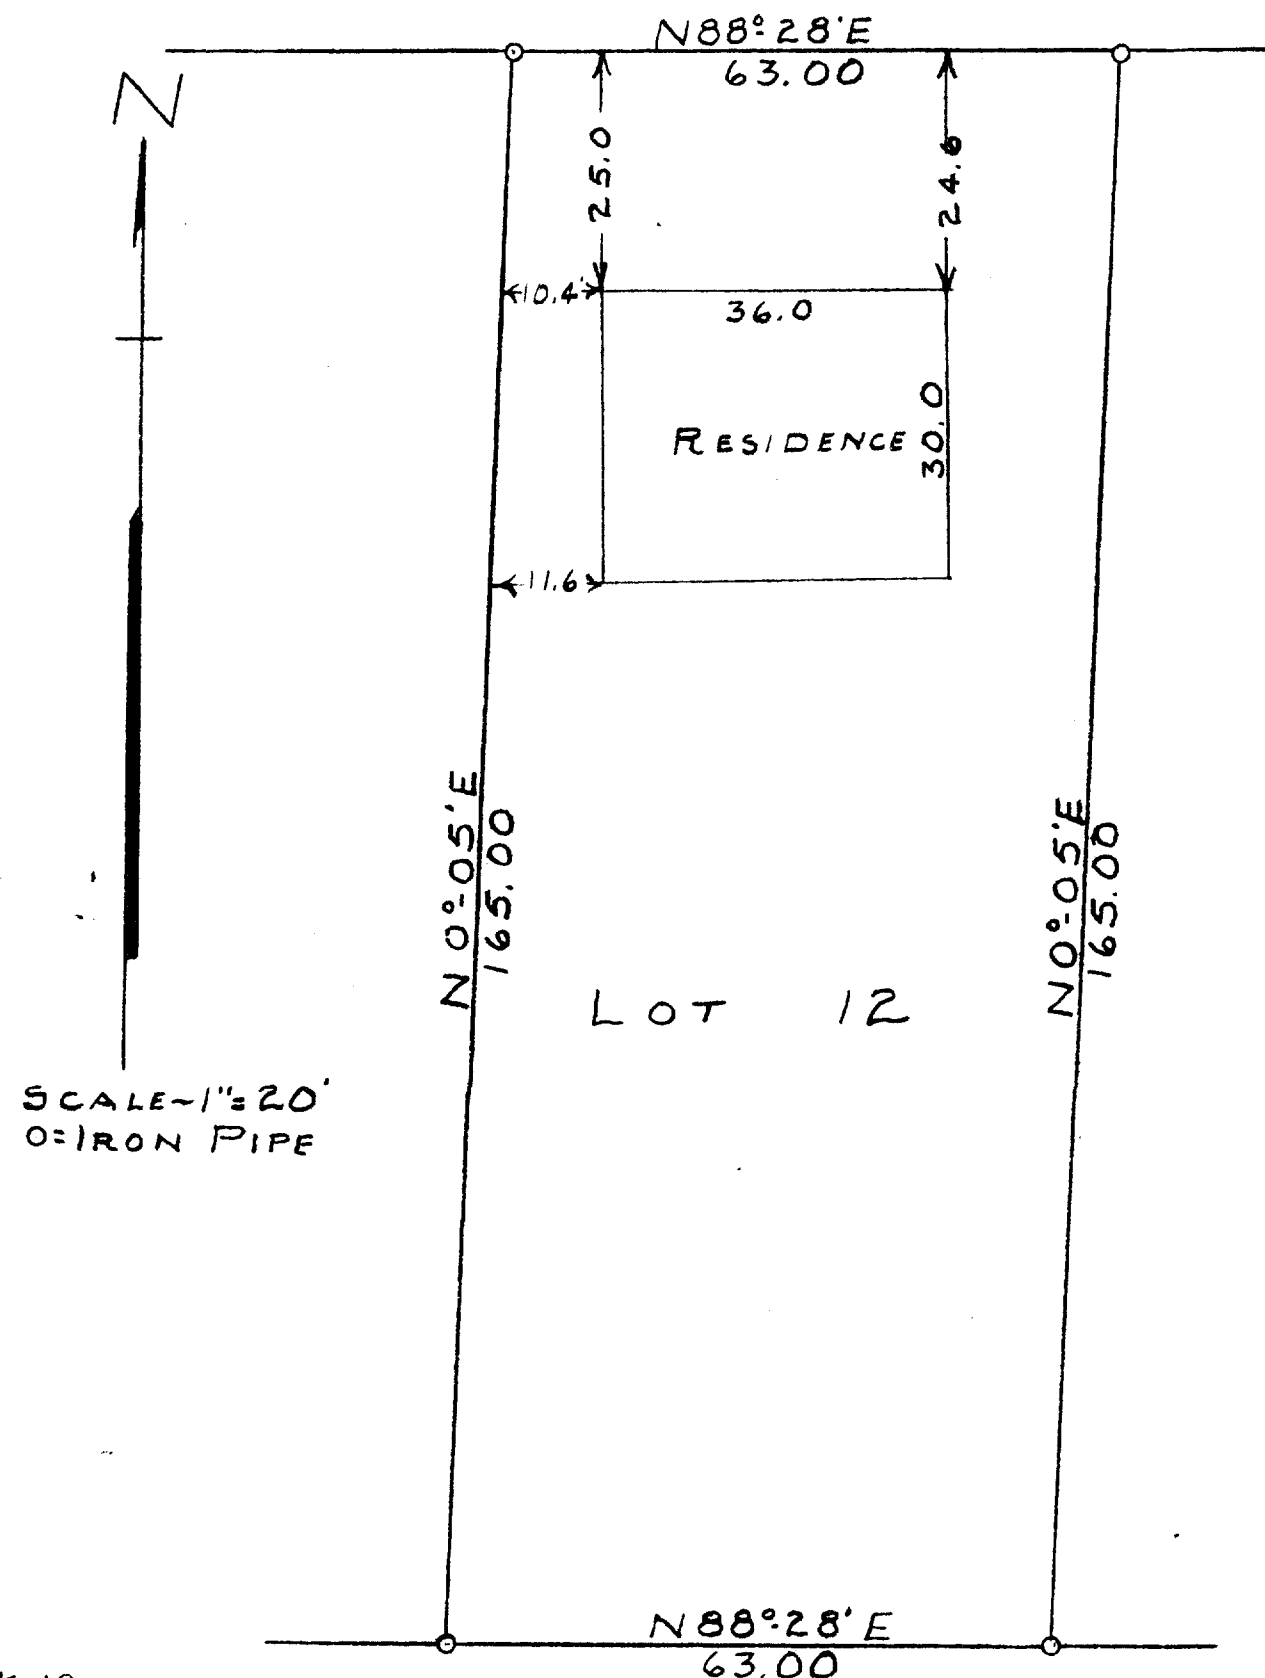

STATE OF WISCONSIN)
WALWORTH COUNTY)

I, GEORGE T. DUNHAM, DO HEREBY CERTIFY THAT
I HAVE SURVEYED THE PROPERTY DESCRIBED AS FOLLOWS:
LOT 12 OF KNAPP'S SUBDIVISION LOCATED IN
THE CITY OF DELAVAN, WALWORTH COUNTY, WISC.
AND THAT THIS PLAT IS A CORRECT REPRESENTATION OF
THE PROPERTY AND OF THE IMPROVEMENTS LOCATED THEREON
NOV. 11, 1957

George T. Dunham
GEORGE T. DUNHAM, SURVEYOR
DELAVAN, WISCONSIN