


Route 4 Box 508B
Elkhorn WI 53121
Phone-414-723-6265

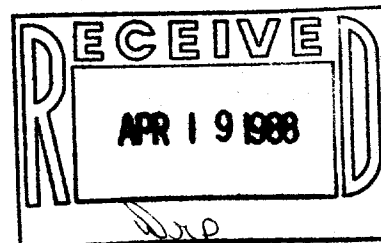


PLAT OF SURVEY OF LOT 39 TURTLE CREEK
SUBDIVISION BEING LOCATED IN SECTION 13
T2N, R15E, CITY OF DELAVAN, WALWORTH COUNTY, WISCONSIN

SURVEY ORDERED BY
FIRST FINANCIAL SAVINGS

BEARING REFERENCE
NORTHERLY LINE OF SYCAMORE STREET ASSUMED TO
BEAR N89°36'02"E AS PLATTED




SCALE 1"=30'

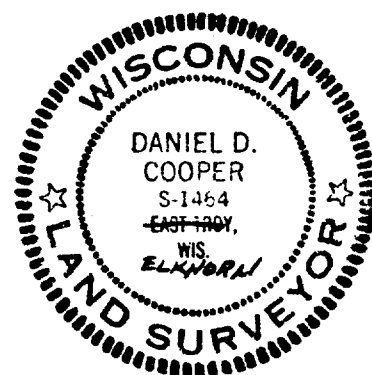

I, DANIEL D. COOPER, REGISTERED SURVEYOR, DO HEREBY CERTIFY THAT I HAVE SURVEYED THE PROPERTY DESCRIBED HEREON AND THAT THE MAP SHOWN HEREON IS A TRUE AND ACCURATE REPRESENTATION THEROF TO THE BEST OF MY PROFESSIONAL KNOWLEDGE AND BELIEF.

DATED THIS 12 DAY OF MAY . 1986

DANIEL D. COOPER, RLS NO. S-1464

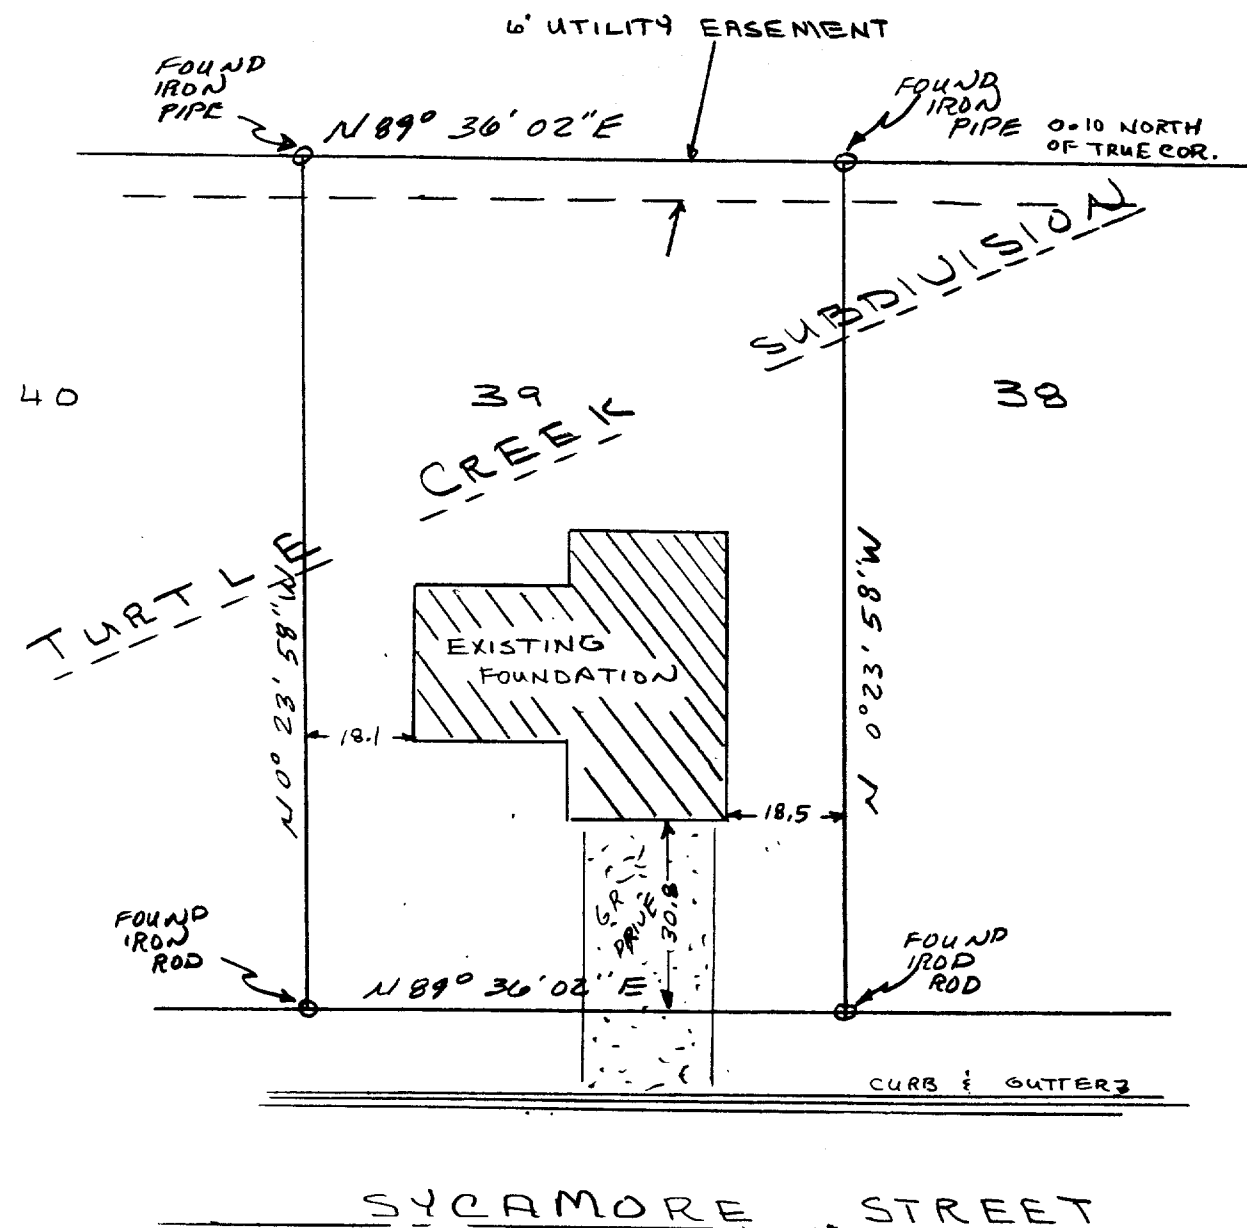

Q-818

DRAWING NO. 2192-4-42