



WISCONSIN STREET

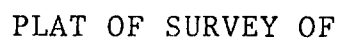

ORDERED BY: THE RAULAND AGENCY
118 KENOSHA ST.
WALWORTH, WI. 53184

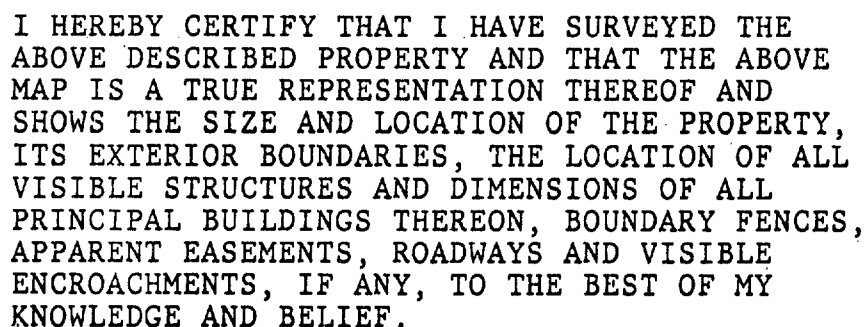

David F. Abell
 DAVID F. ABELL
 WISCONSIN REGISTERED LAND SURVEYOR, S-1596

March 11, 1988

DATE _____ JOB NUMBER - 88023

SCALE - 1"=30'

LEGEND

- Ø - IRON PIPE FOUND
○ - IRON ROD SET
() - RECORDED AS