
ABELL

SURVEYING & MAPPING

DELAVAN, WISCONSIN 53115

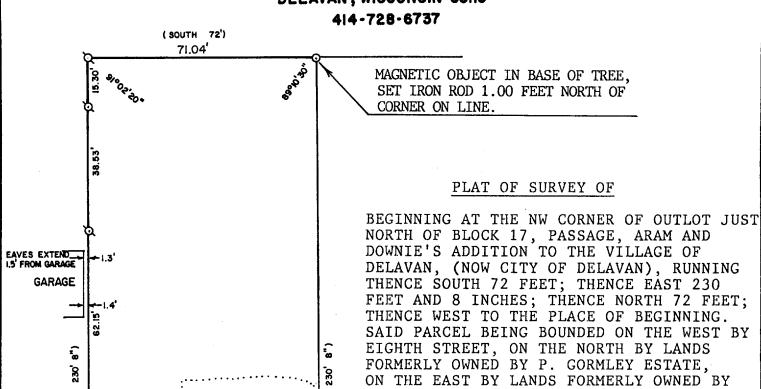


DRIVE

GRAVE

ORDERED BY: CENTURY 21 - SKANDIA REALTY 312 S. 7th STREET DELAVAN, WI. 53115

M. GLASTER, ON THE SOUTH BY LANDS OWNED

BY JOHN SMITH.

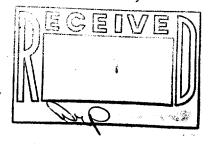

EIGHTH

230.24

OF OUTLOT P, PASSAGE, A CITY OF DEL DECK

71.90' (SOUTH 72')

a HOUSE

STREET



SCALE - 1"=30'

LEGEND

Ø - IRON PIPE FOUND

+ - CUT CROSS IN CONCRETE FOUND

FOUND

O - IRON ROD SET

()- RECORDED AS

I, DAVID F. ABELL, DO HEREBY CERTIFY THAT I HAVE SURVEYED THE PROPERTY HEREON DESCRIBED ACCORDING TO THE OFFICIAL RECORDS AND THAT THE PLAT HEREON IS A CORRECT REPRESENTATION OF THE PROPERTY LINES TO THE BEST OF MY KNOWLEDGE AND BELIEF.

David 7. abell

DAVID F. ABELL

WISCONSIN REGISTERED LAND SURVEYOR, S-1596

February 23, 1988

DATE JOB NUMBER - 88017 NOTE: THIS IS NOT A CERTIFIED COPY UNLESS SEALED.