


WALWORTH

AVENUE

100'

N

SCALE-1"=10'
X=CROSS IN CONC.

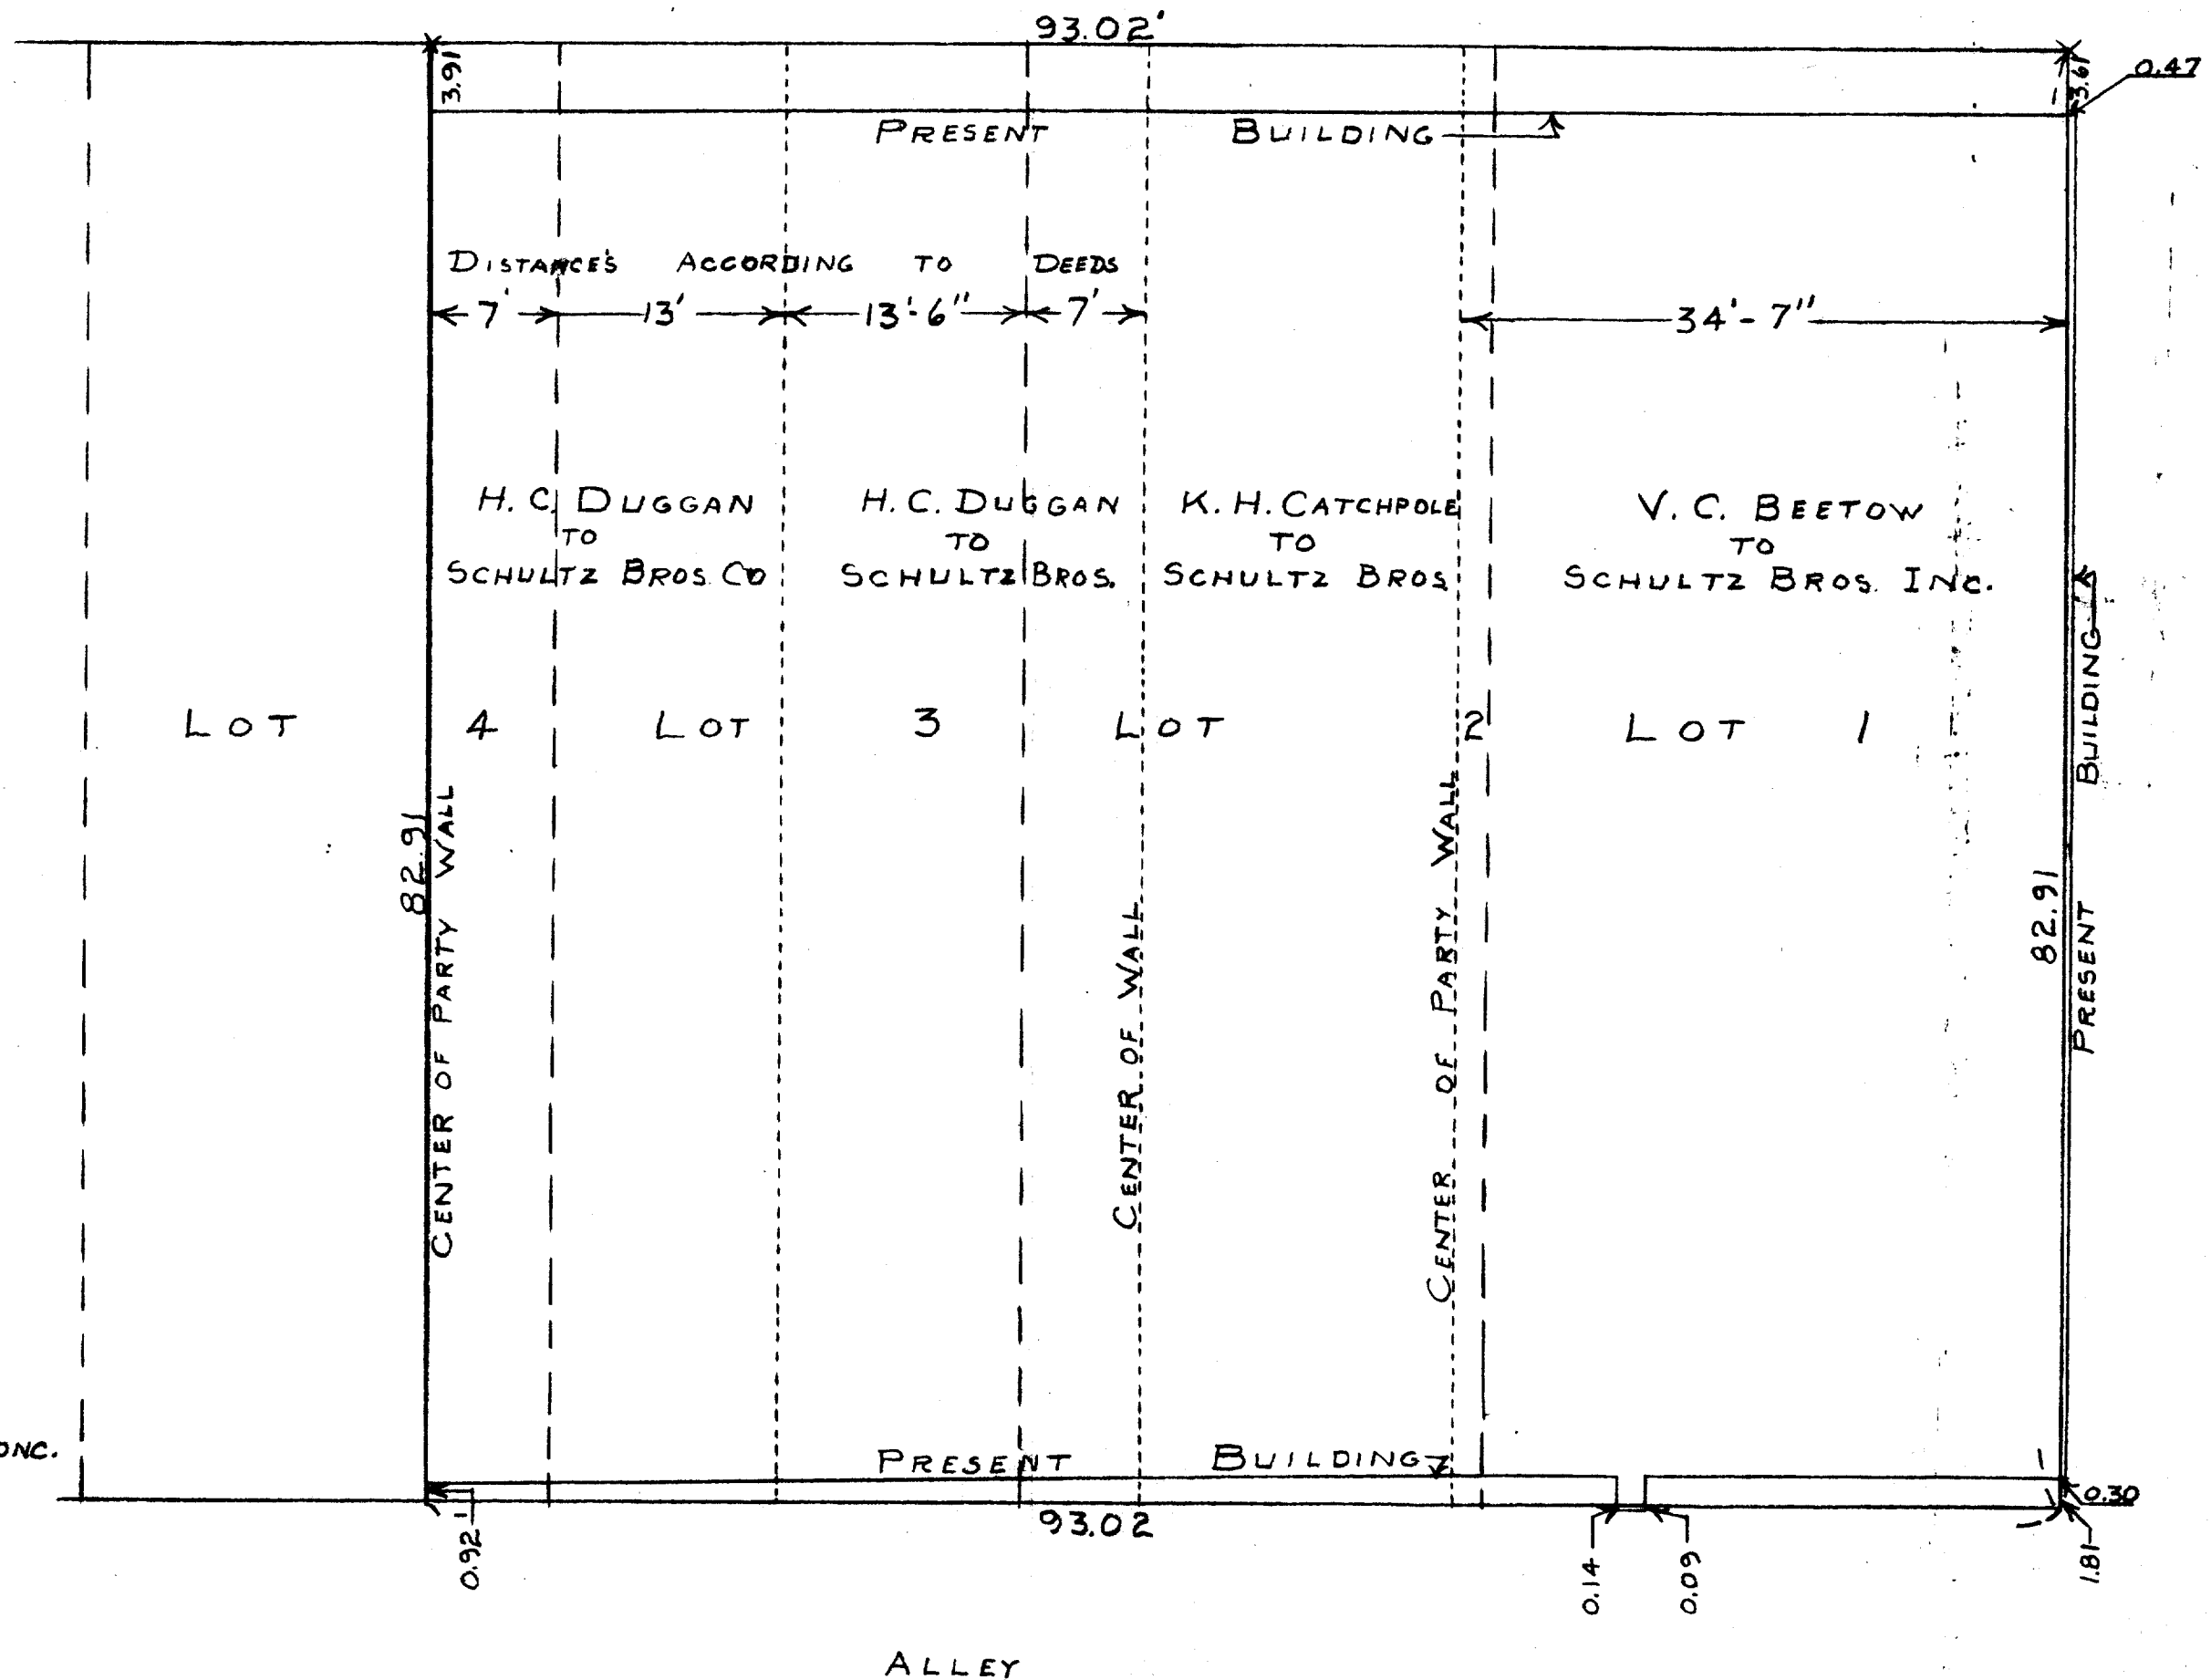

PLAT OF SURVEY OF LAND LOCATED IN LOTS 1, 2, 3 AND PART OF LOT 4,
BLOCK 12 OF THE ORIGINAL PLAT OF THE CITY OF DELAVAN, WALWORTH
COUNTY, WISCONSIN
FEB. 7, 1956

George T. Dunham
GEORGE T. DUNHAM, SURVEYOR
DELAVAN, WISCONSIN

2-9 ✓

XOP-98