


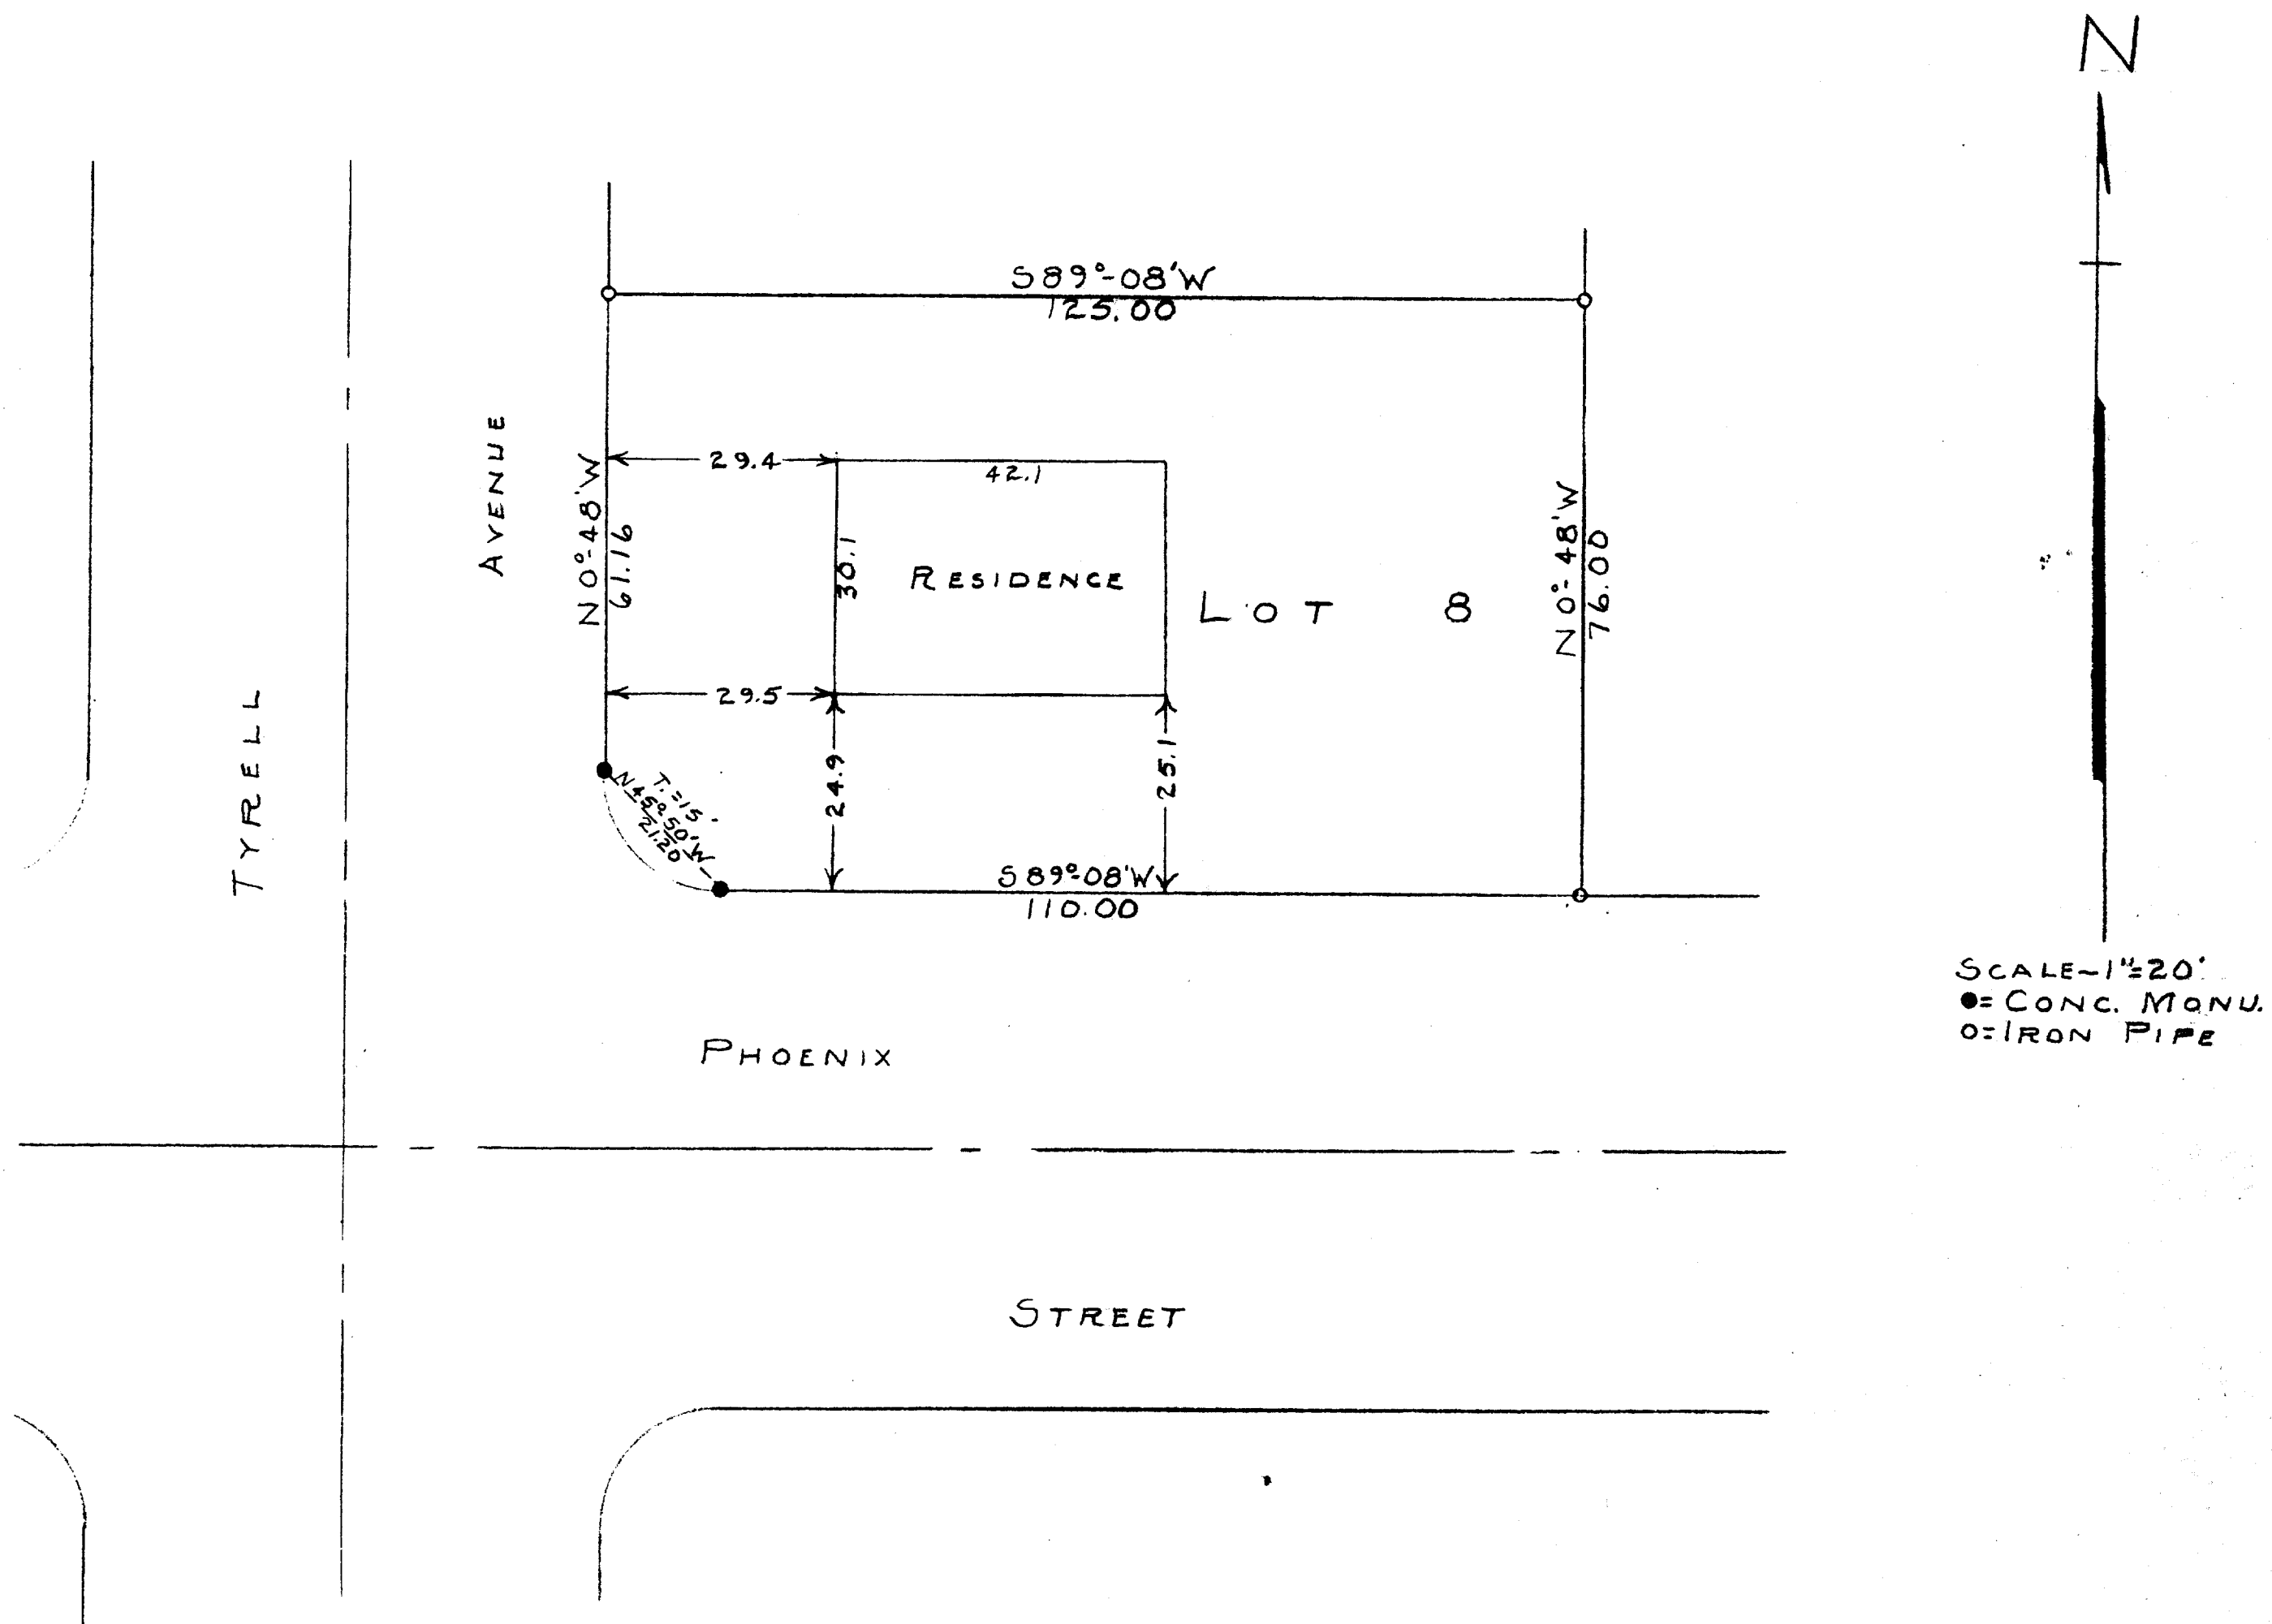

STATE OF WISCONSIN)^{SS}
WALWORTH COUNTY)

I, GEORGE T. DUNHAM, DO HEREBY CERTIFY THAT I HAVE SURVEYED
THE PROPERTY DESCRIBED AS FOLLOWS:

LOT 8, BLOCK 4 OF ALLYNHURST SUBDIVISION LOCATED IN
THE CITY OF DELAVAN, WALWORTH COUNTY, WISCONSIN
AND THAT THE PLAT SHOWN ABOVE IS A CORRECT REPRESENTATION OF
THE PROPERTY LINES AND OF THE IMPROVEMENTS LOCATED THEREON
NOV. 11, 1957

George T. Dunham
GEORGE T. DUNHAM, SURVEYOR
DELAVAN, WISCONSIN

2-99