

PLAT OF LOT 8 BLOCK 14 ALLYNHURST ADDITION NO 3
TO THE CITY OF DELAVAN WALWORTH COUNTY WISCONSIN




D.D. COOPER & CO. INC.

ROUTE 1, BOX 141 B
DELAVAN, WI 53115

PH 414-723-6265

SURVEYING • REALTOR SERVICES


PARK STREET

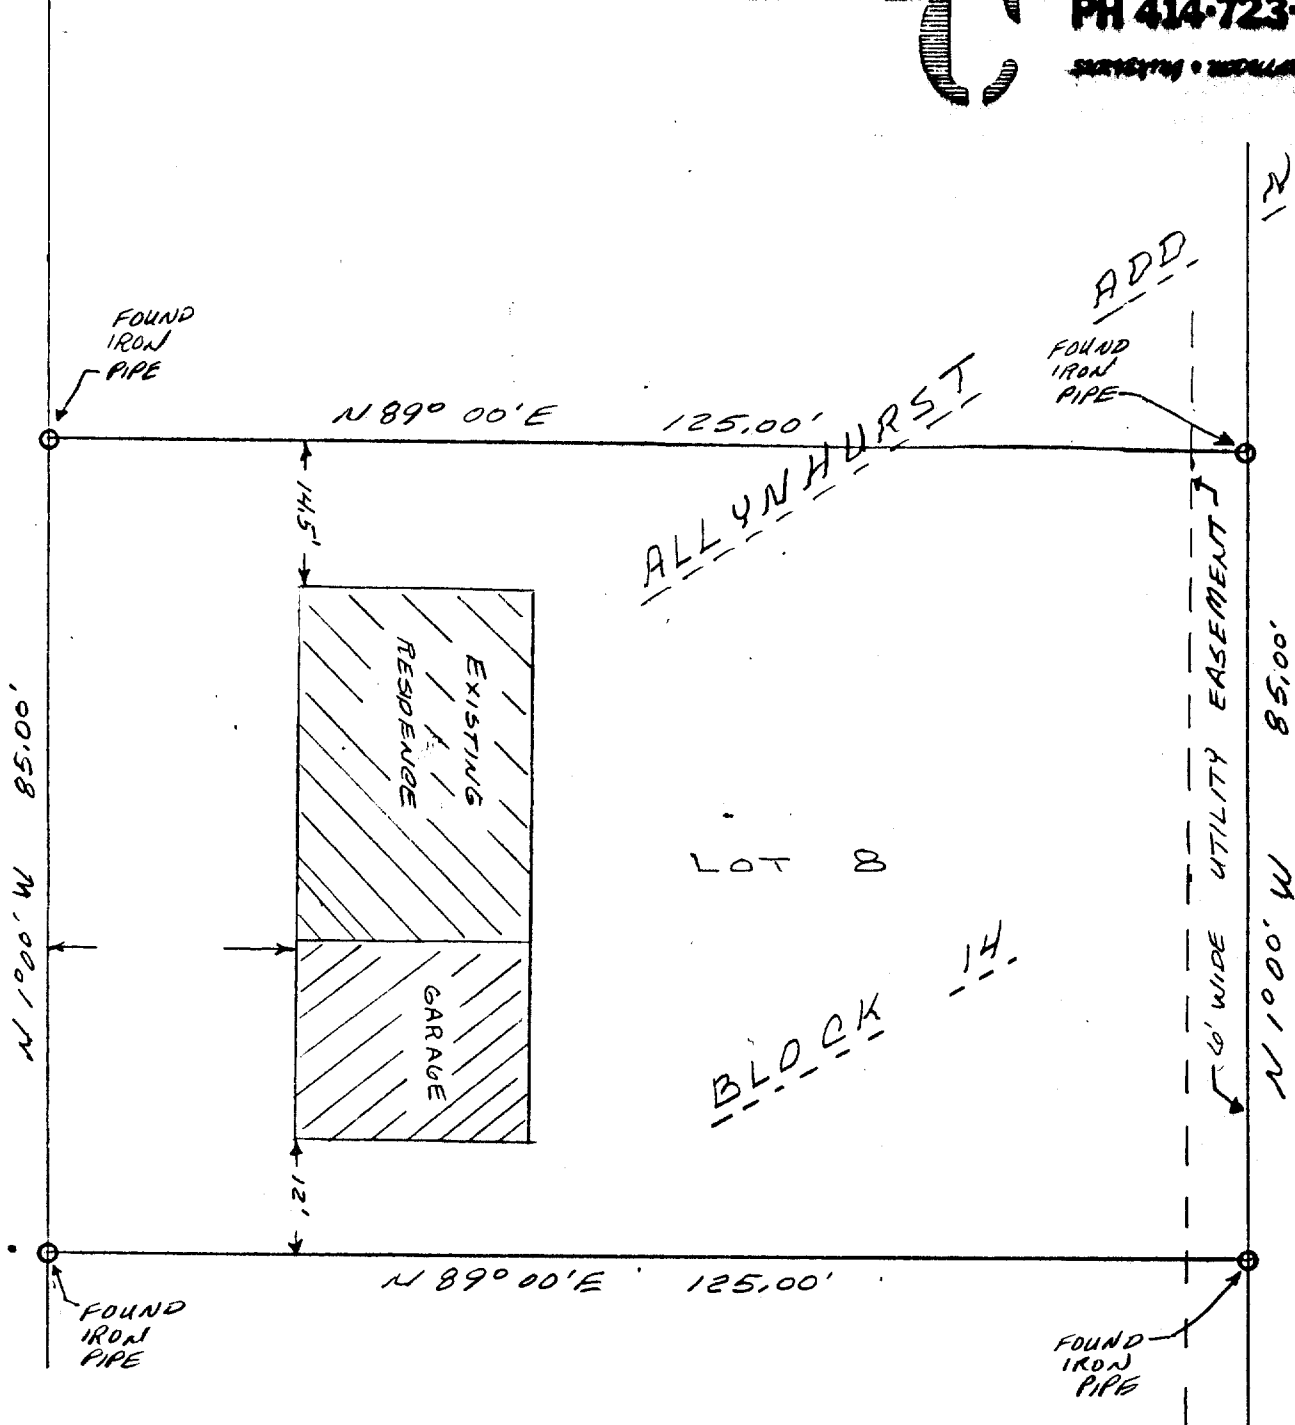

SURVEY ORDERED BY
MARINE BANK SOUTHWEST


I, DANIEL D. COOPER, REGISTERED SURVEYOR, DO HEREBY CERTIFY THAT I HAVE SURVEYED THE PROPERTY DESCRIBED HEREON AND THAT THE MAP SHOWN HEREON IS A TRUE AND ACCURATE REPRESENTATION THEREOF TO THE BEST OF MY PROFESSIONAL KNOWLEDGE AND BELIEF.

DATED THIS 18 DAY OF Sept., 1965 *Daniel D. Cooper*
DANIEL D. COOPER, RLS NO. 8-1464

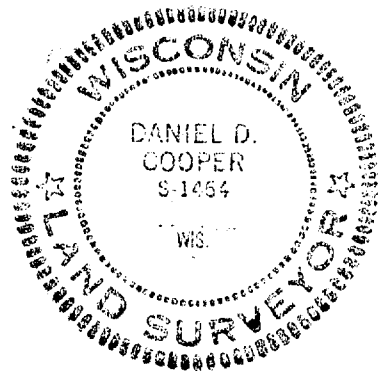

SCALE 1" = 20'

BEARING REFERENCE:
EASTERLY LINE OF PARK STREET ASSUMED TO BEAR $N 1^{\circ} 00' W$ AS PLATTED

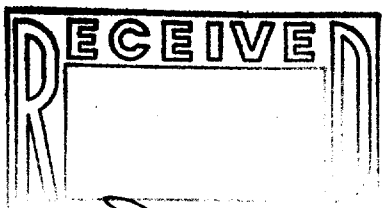

DRAWING NO. 2019-2-59-

XA534

2-799