


N
 SCALE 1" = 20'
 0" = IRON PIPE

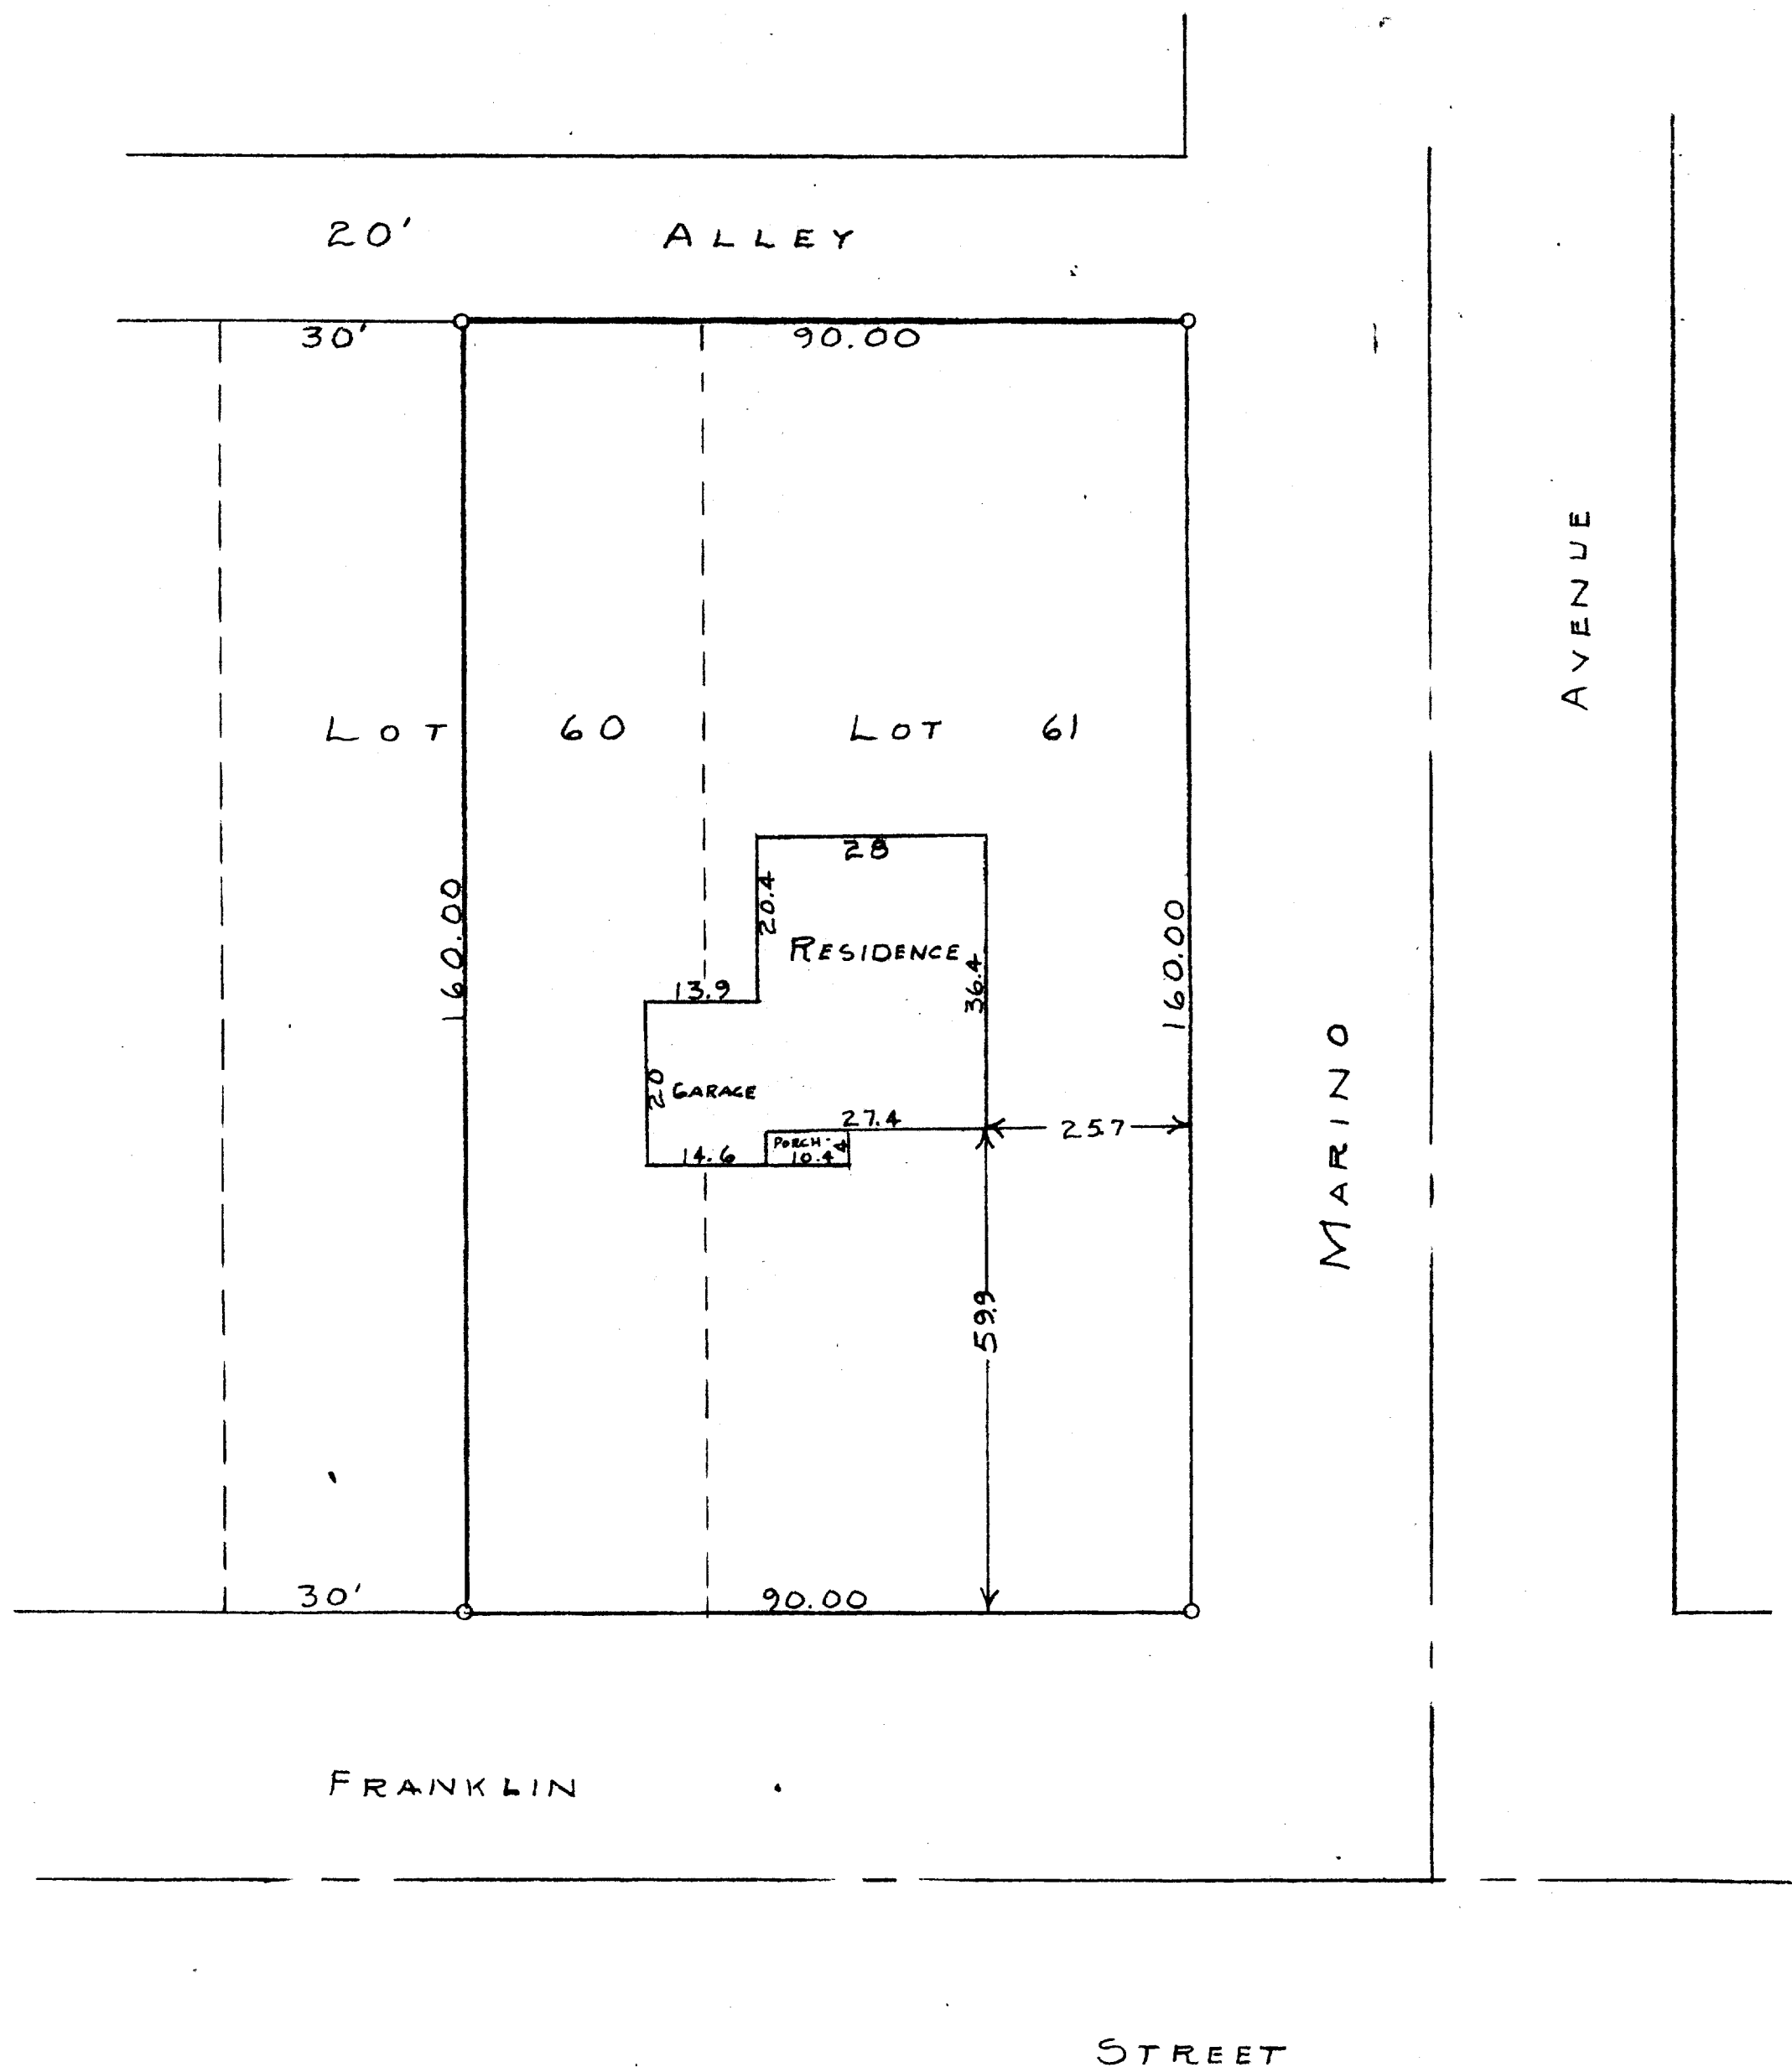

STATE OF WISCONSIN)
 WALWORTH COUNTY)
 I, GEORGE T. DUNHAM, DO HEREBY CERTIFY THAT I HAVE SURVEYED
 THE PROPERTY DESCRIBED AS FOLLOWS:
 LOT 61 AND THE EAST 1/2 LOT 60 OF MAR-DEL ESTATES LOCATED
 IN THE CITY OF DELAVAN, WALWORTH COUNTY, WISCONSIN
 AND THAT THE PLAT SHOWN ABOVE IS A CORRECT REPRESENTATION OF THE
 PROPERTY LINES AND OF THE IMPROVEMENTS LOCATED THEREON
 JUNE 3, 1958

George T. Dunham
 GEORGE T. DUNHAM, SURVEYOR
 DELAVAN, WISCONSIN

2-102