
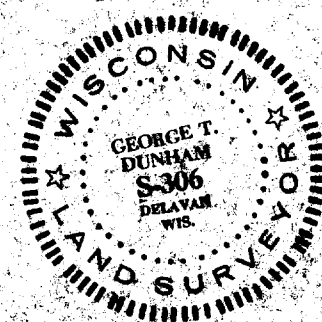
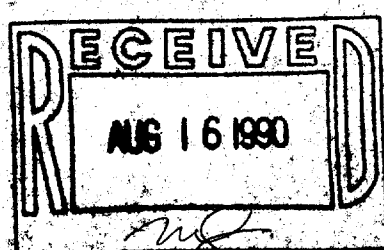


WALWORTH AVENUE

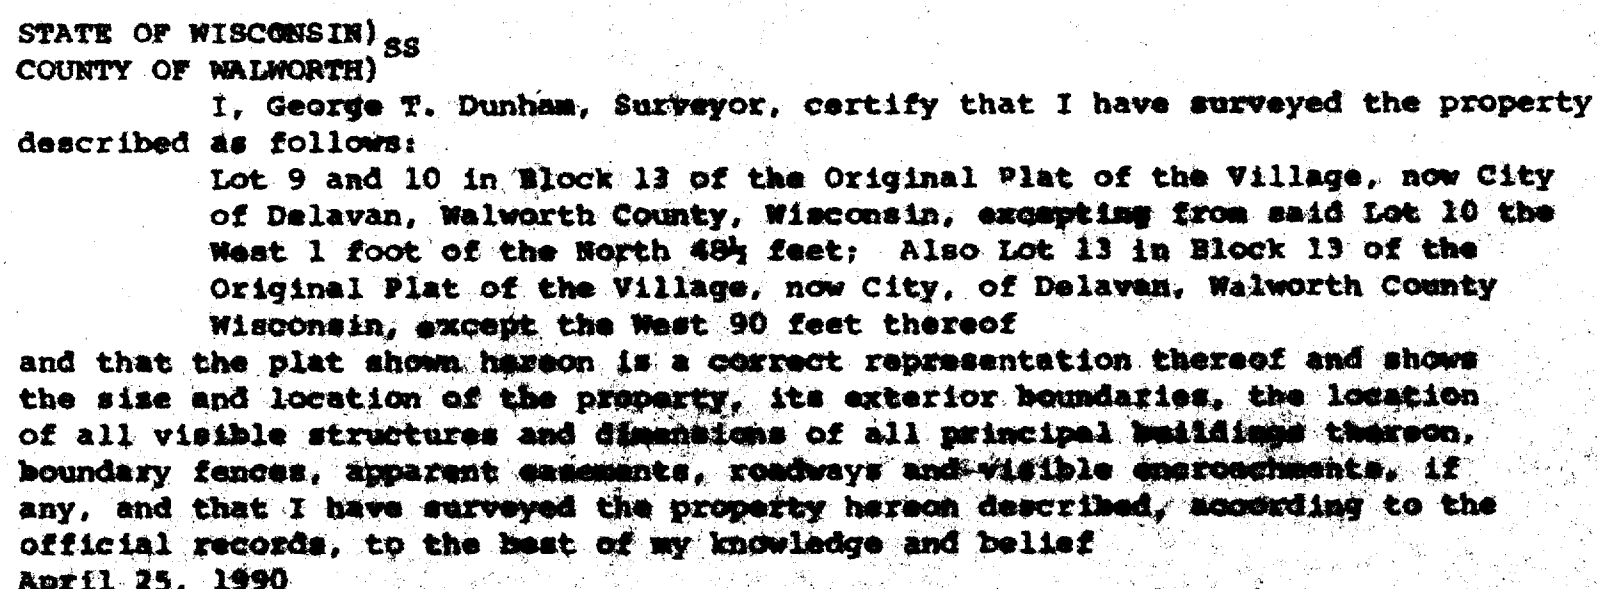

Survey# 002-1021