
ABELL SURVEYING & MAPPING DELAYAN, WISCONSIN 63116 414-720-6787



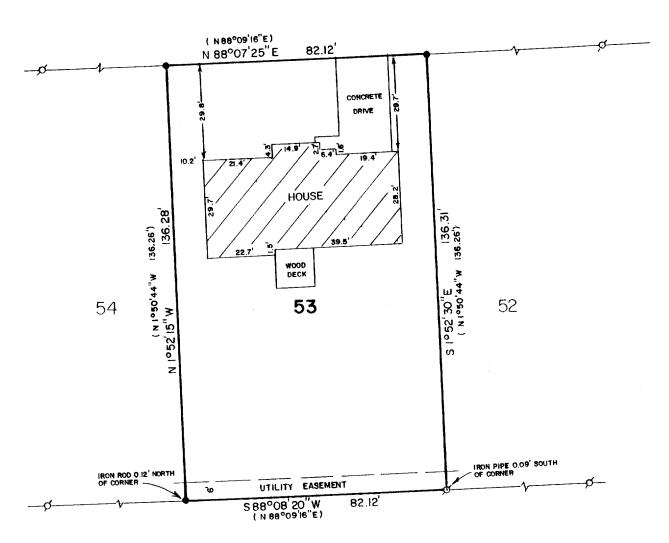


PLAT OF SURVEY OF

LOT 53 OF THE FIRST ADDITION TO TODD MILLER SUBDIVISION, LOCATED IN THE CITY OF DELAVAN, WALWORTH COUNTY, WISCONSIN.

ORDERED BY:

KEEFE REAL ESTATE 704 MAIN STREET LAKE GENEVA, WI. 53147

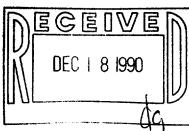

I HEREBY CERTIFY THAT I HAVE SURVEYED THE ABOVE DESCRIBED PROPERTY AND THAT THE ABOVE HAP IS A TRUE REPRESENTATION THEREOF AND SHOWS THE SIZE AND LOCATION OF THE PROPERTY, ITS EXTERIOR BOUNDARIES, THE LOCATION OF ALL VISIBLE STRUCTURES AND DIMENSIONS OF ALL PRINCIPAL BUILDINGS THEREON, BOUNDARY FENCES, APPARENT EASEMENTS, ROADWAYS AND VISIBLE ENCROACHMENTS, IF ANY, TO THE BEST OF MY KNOWLEDGE AND BELLEF.

THIS SURVEY IS MADE FOR THE USE OF THE PRESENT OWNERS OF THE PROPERTY, AND ALSO THOSE WHO PURCHASE, HORTGAGE, OR GUARANTEE THE TITLE THERETO WITHIN ONE (1) YEAR FROM DATE HEREOF.

Said 7. abell

DAVID F. ABELL WISCONSIN REGISTERED LAND SURVEYOR, S-1596

DATE: THIS IS NOT A CERTIFIED COTY UNLESS SEALED.

SCALE - 1"=30'
LEGEND

PIPE FOUND

• - IRON PIPE FOUND
• - IRON ROD FOUND
()- RECORDED AS

DD-1031