ABELL


SURVEYING & MAPPING

DELAVAN, WISCONSIN 53115 414-729-6787

PHOENIX

STREET

6.0

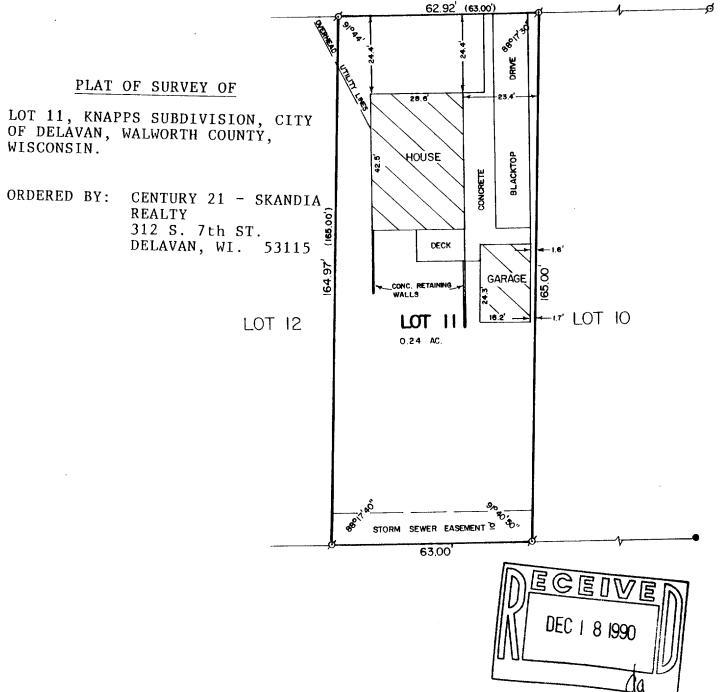



SCALE - 1"=30'

LEGEND

ø − IR<mark>ON PIP</mark>E FOUND

• - CONCRETE MONUMENT

FOUND

()- RECORDED AS

I HEREBY CERTIFY THAT I HAVE SURVEYED THE ABOVE DESCRIBED PROPERTY AND THAT THE ABOVE HAP IS A TRUE REPRESENTATION THEREOF AND SHOWS THE SIZE AND LOCATION OF THE PROPERTY, ITS EXTERIOR BOUNDARIES, THE LOCATION OF ALL VISIBLE STRUCTURES AND DIMENSIONS OF ALL PRINCIPAL BUILDINGS THEREON, BOUNDARY FENCES, APPARENT EASEHENTS, ROADWAYS AND VISIBLE ENCROACHMENTS, IF ANY, TO THE BEST OF MY KNOWLEDGE AND BELIEF.

THIS SURVEY IS MADE FOR THE USE OF THE PRESENT OWNERS OF THE PROPERTY, AND ALSO THOSE WHO PURCHASE, MORTGAGE, OR GUARANTEE THE TITLE THERETO WITHIN ONE (1) YEAR FROM DATE HEREOF.

David 7. abell

WISCONSIN REGISTERED LAND SURVEYOR, S-1596

May 31 1990
NATE JOB NUMBER = 90098
OTE: THIS IS NOT A CERTIFIED COPY UNLESS SEALED.