

ABELL SURVEYING & MAPPING

DELAVAN, WISCONSIN 53115 414-728-6737

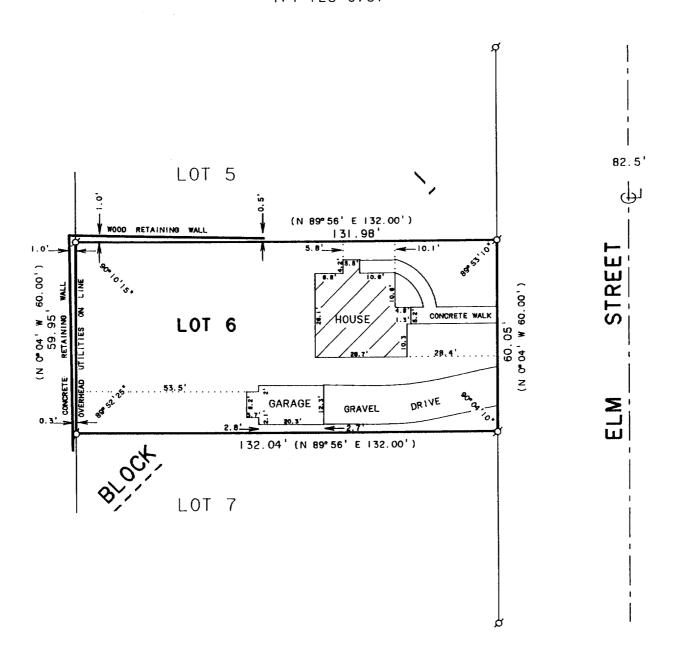


PLAT OF SURVEY OF

LOT 6. BLOCK I, SUNSET VIEW SUBDIVISION, CITY OF DELAVAN, WALWORTH COUNTY, WISCONSIN.

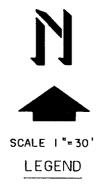

Ø -IRON PIPE FOUND
()-RECORDED AS

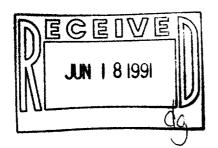

ORDERED BY: MARK WENDORF
218 ELM STREET
DELAVAN, WI. 53115

I HEREBY CERTIFY THAT I HAVE SURVEYED THE ABOVE DESCRIBED PROPERTY AND THAT THE ABOVE MAP IS A TRUE REPRESENTATION THEREOF AND SHOWS THE SIZE AND LOCATION OF THE PROPERTY, ITS EXTERIOR BOUNDARIES. THE LOCATION OF ALL VISIBLE STRUCTURES AND DIMENSIONS OF ALL PRINCIPAL BUILDINGS THEREON. BOUNDARY FENCES. APPARENT EASEMENTS, ROADWAYS AND VISIBLE ENCROACHMENTS, IF ANY, TO THE BEST OF MY KNOWLEDGE AND BELIEF.

THIS SURVEY IS MADE FOR THE USE OF THE PRESENT OWNERS OF THE PROPERTY, AND ALSO THOSE WHO PURCHASE, MORTGAGE, OR GUARANTEE THE TITLE THERETO WITHIN ONE (I) YEAR FROM DATE HEREOF.

Dand T. C

WISCONSIN REGISTERED LAND SURVEYOR, S-1596

March 5, 1991

JOB NUMBER - 91031

NOTE: THIS IS NOT A CERTIFIED COPY UNLESS SEALED.