
ABELL SURVEYING & MAPPING

DELAVAN. WISCONSIN 53115 414-728-6737

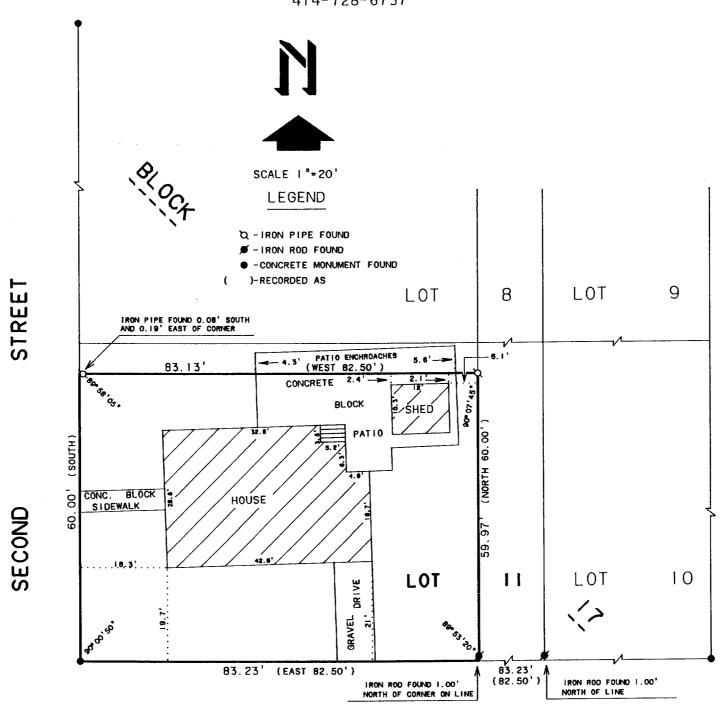

WISCONSIN

STREET

PLAT OF SURVEY OF

A PARCEL OF LAND LOCATED IN LOT II. BLOCK 17. OF THE ORIGINAL PLAT OF THE VILLAGE. (NOW CITY) OF DELAVAN, WALWORTH COUNTY, WISCONSIN. AND MORE PARTICULARY DESCRIBED AS FOLLOWS:
BEGINNING AT THE SOUTHWEST CORNER OF SAID LOT II: THENCE EAST ALONG THE SOUTH LINE OF SAID LOT II 82.50 FEET: THENCE NORTH IN A LINE PARALLEL TO THE WESTERLY LINE OF SAID LOT II 60.00 FEET: THENCE WEST IN A LINE PARALLEL TO THE SOUTHERLY LINE OF SAID LOT II 82.50 FEET: THENCE SOUTHERLY ALONG THE WESTERLY LINE OF SAID LOT II 60.00 FEET TO THE PLACE OF BEGINNING.

ORDERED BY: THE RAULAND AGENCY
118 KENOSHA STREET
WALWORTH, WI. 53185



I HEREBY CERTIFY THAT I HAVE SURVEYED THE ABOVE DESCRIBED PROPERTY AND THAT THE ABOVE MAP IS A TRUE REPRESENTATION THEREOF AND SHOWS THE SIZE AND LOCATION OF THE PROPERTY, ITS EXTERIOR BOUNDARIES, THE LOCATION OF ALL VISIBLE STRUCTURES AND DIMENSIONS OF ALL PRINCIPAL BUILDINGS THEREON, BOUNDARY FENCES, APPARENT EASEMENTS, ROADWAYS AND VISIBLE ENCROACHMENTS, IF ANY, TO THE BEST OF MY KNOWLEDGE AND BELIEF.

THIS SURVEY IS MADE FOR THE USE OF THE PRESENT OWNERS OF THE PROPERTY, AND ALSO THOSE WHO PURCHASE, MORTGAGE, OR GUARANTEE THE TITLE THERETO WITHIN ONE (I) YEAR FROM_DATE HEREOF.

Naid F. U

DAVID F. ABELL WISCONSIN REGISTERED LAND SURVEYOR, S-1596

March 13, 1991

JOB NUMBER - 91033

NOTE: THIS IS NOT A CERTIFIED COPY UNLESS SEALED.