


414-728-6737

Block

LOT 3

149.79' OLD FENCE JUST NORTH OF LINE

TERRACE STREET

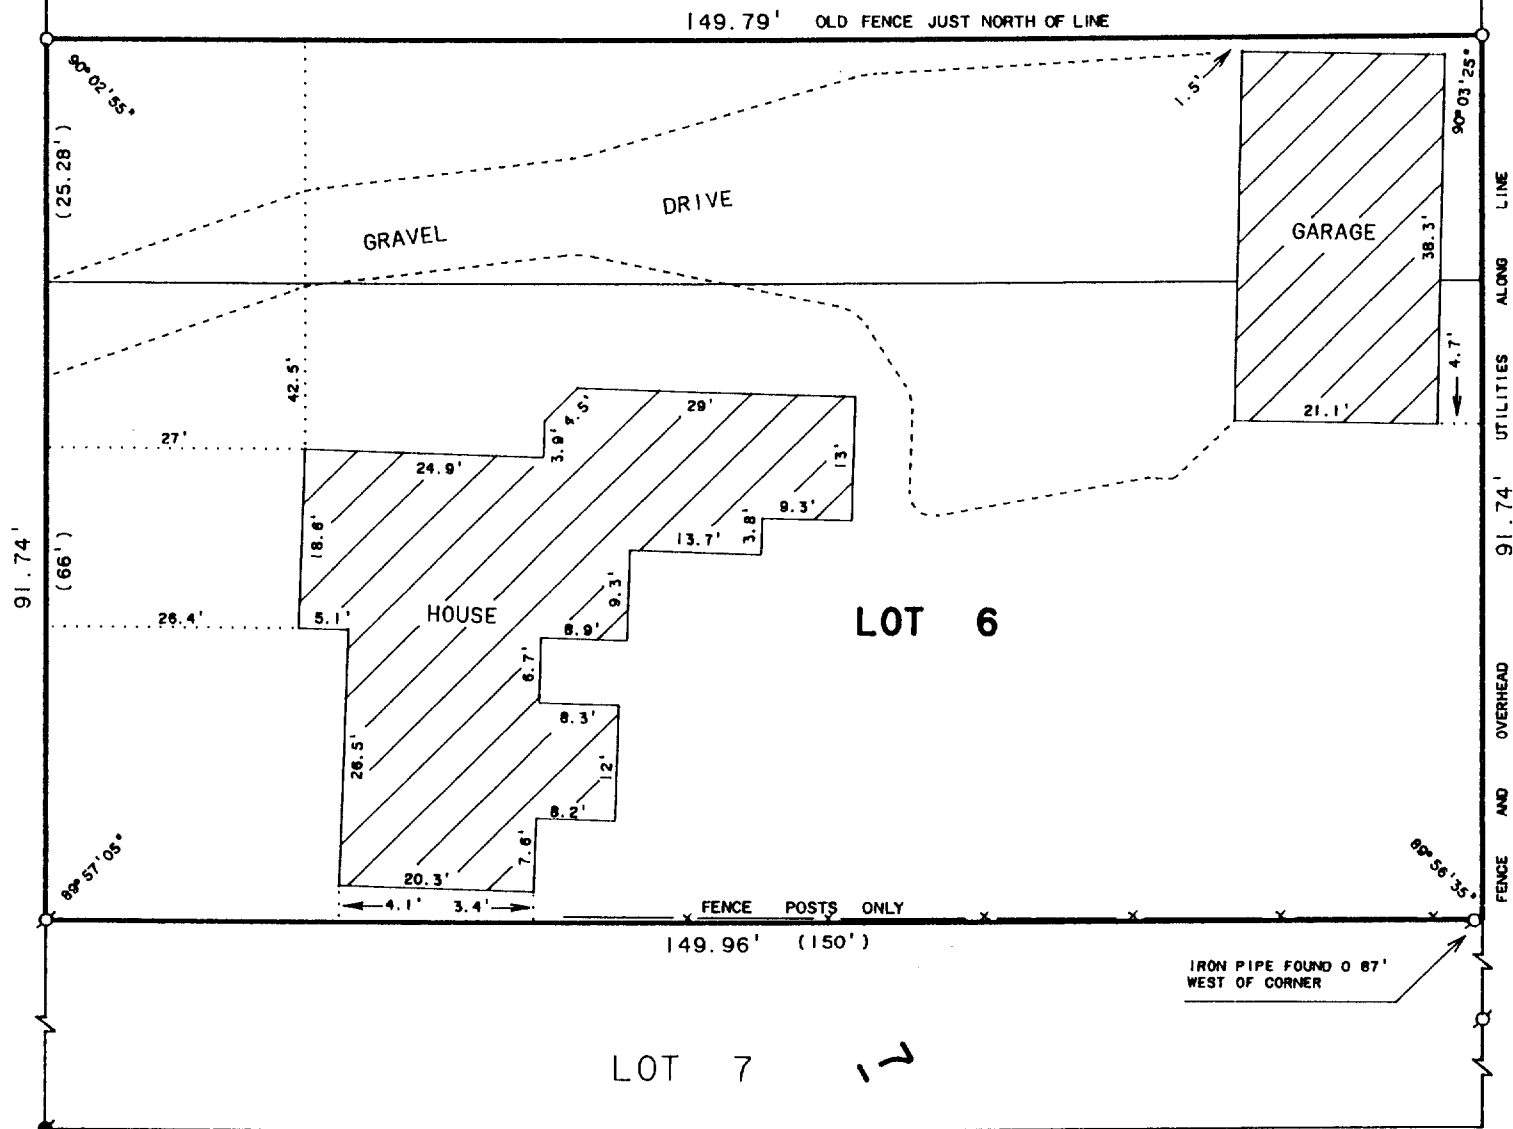

WALWORTH

AVENUE

PLAT OF SURVEY OF

LOT 6 AND THE SOUTH 25.28 FEET OF LOT 7, BLOCK 7, ORIGINAL
PLAT, CITY OF DELAVAN, WALWORTH COUNTY, WISCONSIN.




SCALE 1" = 20'

LEGEND

- ♂ - IRON PIPE FOUND
 ■ - CONCRETE MONUMENT FOUND
 ○ - IRON PIPE SET
 () - RECORDED AS

ORDERED BY: CENTURY 21-SKANDIA REALTY
312 S. 7th STREET
DELAVER, WI. 53115

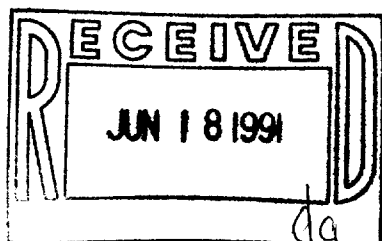

I HEREBY CERTIFY THAT I HAVE SURVEYED THE ABOVE DESCRIBED PROPERTY AND THAT THE ABOVE MAP IS A TRUE REPRESENTATION THEREOF AND SHOWS THE SIZE AND LOCATION OF THE PROPERTY, ITS EXTERIOR BOUNDARIES, THE LOCATION OF ALL VISIBLE STRUCTURES AND DIMENSIONS OF ALL PRINCIPAL BUILDINGS THEREON, BOUNDARY FENCES, APPARENT EASEMENTS, ROADWAYS AND VISIBLE ENCROACHMENTS, IF ANY, TO THE BEST OF MY KNOWLEDGE AND BELIEF.

THIS SURVEY IS MADE FOR THE USE OF THE PRESENT OWNERS OF THE PROPERTY, AND ALSO THOSE WHO PURCHASE, MORTGAGE, OR GUARANTEE THE TITLE THERETO WITHIN ONE (1) YEAR FROM DATE HEREOF.

DAVID F. ABELL

WISCONSIN REGISTERED LAND SURVEYOR, S-1596

April 25, 1991

DATE _____ JOB NUMBER - 91069

NOTE: THIS IS NOT A CERTIFIED COPY UNLESS SEALED.

002-1065

XOR 000033