
Plat of Survey

Lot 35 of the First Addition to Tod Miller Subdivision, located in the Northeast 1/4 of Section 19, Town 2 North, Range 16 East, City of Delavan, Walworth County, Wisconsin.

Surveyed for: Ed Wellnitz Builder, Inc. 1001 Highway 14 North

Janesville, Wisconsin. 53545

Bearings referenced to the

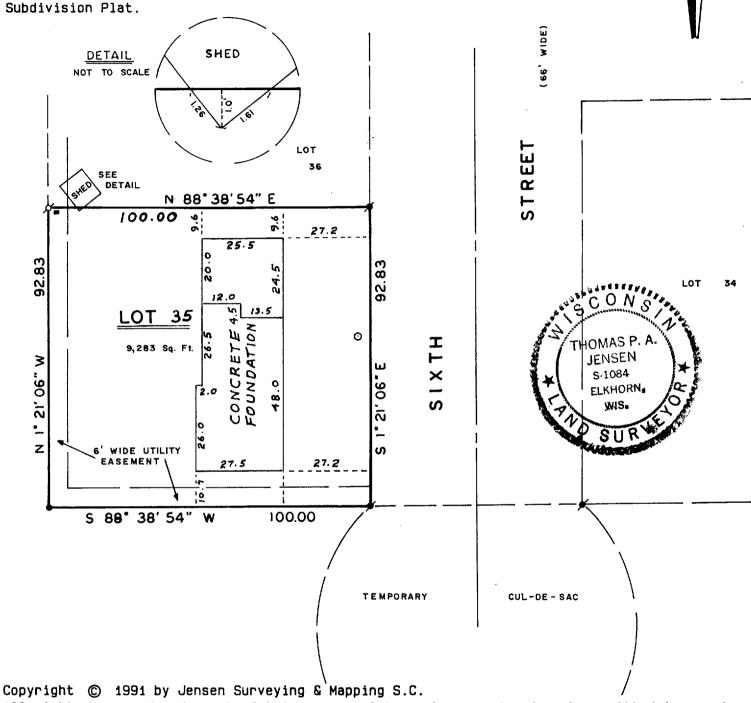

All rights reserved. No part of this survey plat may be reproduced or transmitted in any form by any means - graphic, electronic, or mechanical, including photocopying, tracing, or information storage and retrieval systems - without permission in writing from Thomas P.A. Jensen.

I. Thomas P.A. Jensen, Wisconsin Registered Land Surveyor, do hereby certify that this survey was performed by me, or under my direction, in full compliance with the owner's/agent's instructions and Chapter A-E 7 of the Wisconsin Administrative Code ' Minimum Standards For Property Surveys ', and that this map is an accurate representation thereof to the best of my knowledge and belief.

OCT 2 9 1991

Note: This survey plat is not certified unless signed and sealed in red ink.

Jensen Surveying & Mapping S.C. Mapping date: January 31, 1991

Revisions: FEB. 15, 1991

Uous

Ťhomas P.A. Jen∕sen

45 South Wisconsin Street P.O. Box 322 Elkhorn, Wisconsin. 53121.

(414) 723-3434

Sheet 1 of 1 Sheets

Job reference number: 1991.018

R.L.S.

1084

Legend

• ~ Set iron rod 3/4 dia.

() ~ Recorded as dimension

- - Utility box O~Water valve

002-1070

Scale: 1 = 30'

90 XM1A-46009 60 15 30