


**ABELL
SURVEYING & MAPPING**

DELAVAN, WISCONSIN 53115

414-728-6737

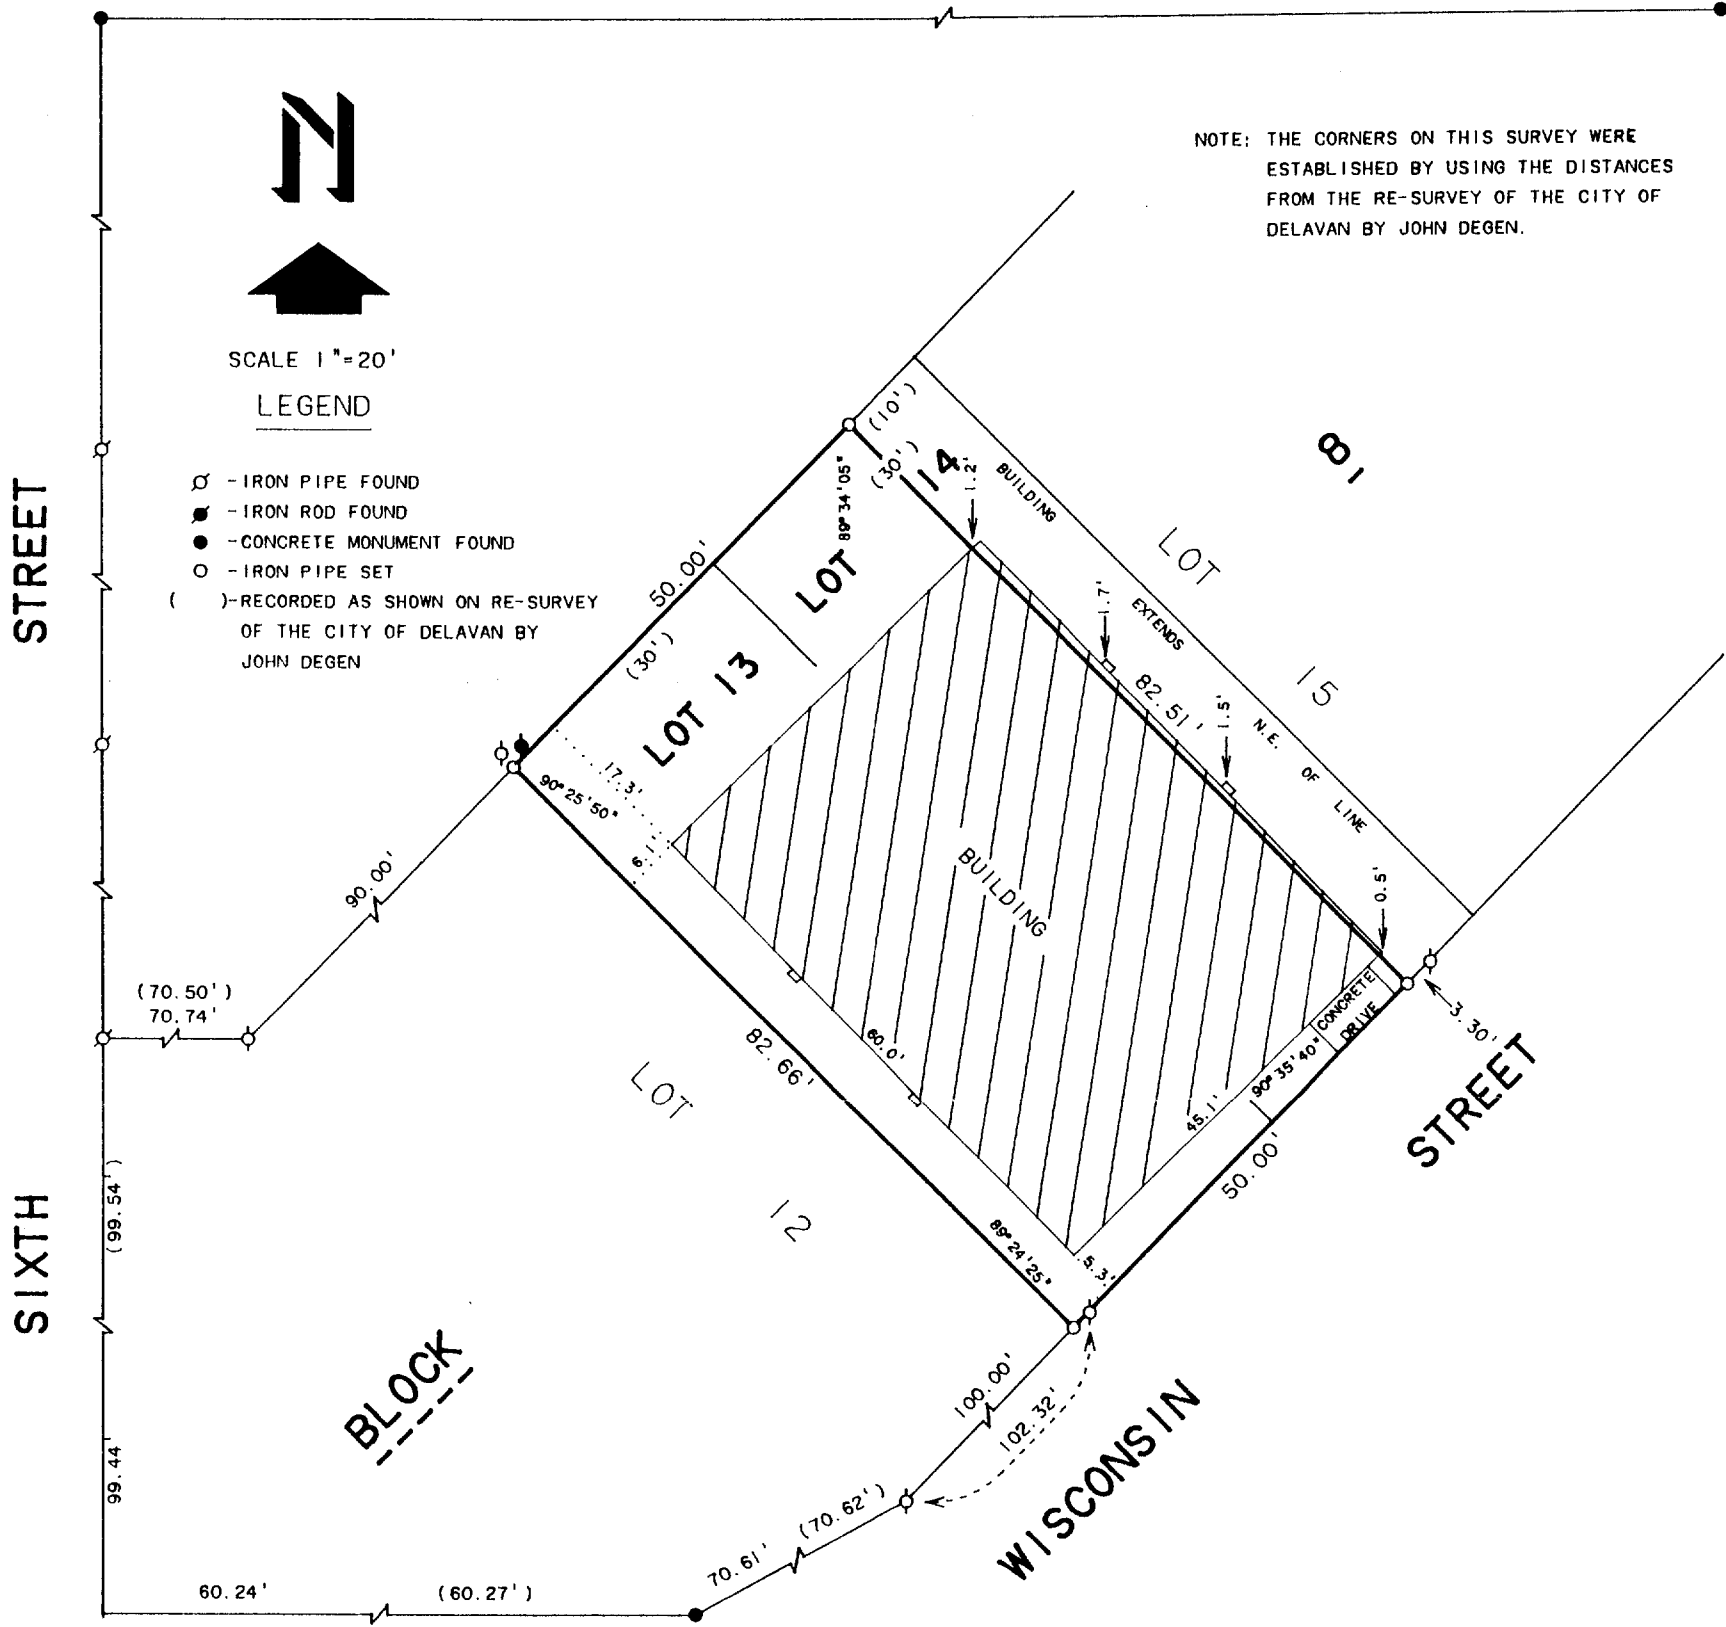

NOTE: THE CORNERS ON THIS SURVEY WERE ESTABLISHED BY USING THE DISTANCES FROM THE RE-SURVEY OF THE CITY OF DELAVAN BY JOHN DEGEN.



SCALE 1"=20'

LEGEND

- - IRON PIPE FOUND
- - IRON ROD FOUND
- - CONCRETE MONUMENT FOUND
- - IRON PIPE SET
- () - RECORDED AS SHOWN ON RE-SURVEY OF THE CITY OF DELAVAN BY JOHN DEGEN

SIXTH STREET


SIXTH STREET

WISCONSIN STREET

PLAT OF SURVEY OF

All of Lots 13 and 14, in Block 8, of Passage, Aram and Downie's Addition to the Village, now City, of Delavan, excepting and reserving a strip of land of the uniform width of 10 feet off the entire northeasterly side of Lot 14.

Tax Key Number: XP 00132

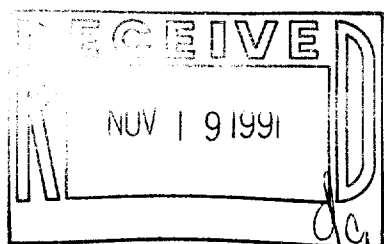

I HEREBY CERTIFY THAT I HAVE SURVEYED THE ABOVE DESCRIBED PROPERTY AND THAT THE ABOVE MAP IS A TRUE REPRESENTATION THEREOF AND SHOWS THE SIZE AND LOCATION OF THE PROPERTY, ITS EXTERIOR BOUNDARIES, THE LOCATION OF ALL VISIBLE STRUCTURES AND DIMENSIONS OF ALL PRINCIPAL BUILDINGS THEREON, BOUNDARY FENCES, APPARENT EASEMENTS, ROADWAYS AND VISIBLE ENCROACHMENTS, IF ANY, TO THE BEST OF MY KNOWLEDGE AND BELIEF.

THIS SURVEY IS MADE FOR THE USE OF THE PRESENT OWNERS OF THE PROPERTY, AND ALSO THOSE WHO PURCHASE, MORTGAGE, OR GUARANTEE THE TITLE THERETO WITHIN ONE (1) YEAR FROM DATE HEREOF.

David F. Abell
DAVID F. ABELL

WISCONSIN REGISTERED LAND SURVEYOR, S-1596

ORDERED BY: PROFESSIONAL REALTY
706 E. GENEVA ST.
DELAVAN, WI. 53115

October 29, 1991

DATE JOB NUMBER - 91228

NOTE: THIS IS NOT A CERTIFIED COPY UNLESS SEALED.