


N

Survey ordered by: Doug Yadon  
M. Terrace St  
Delavan, WI

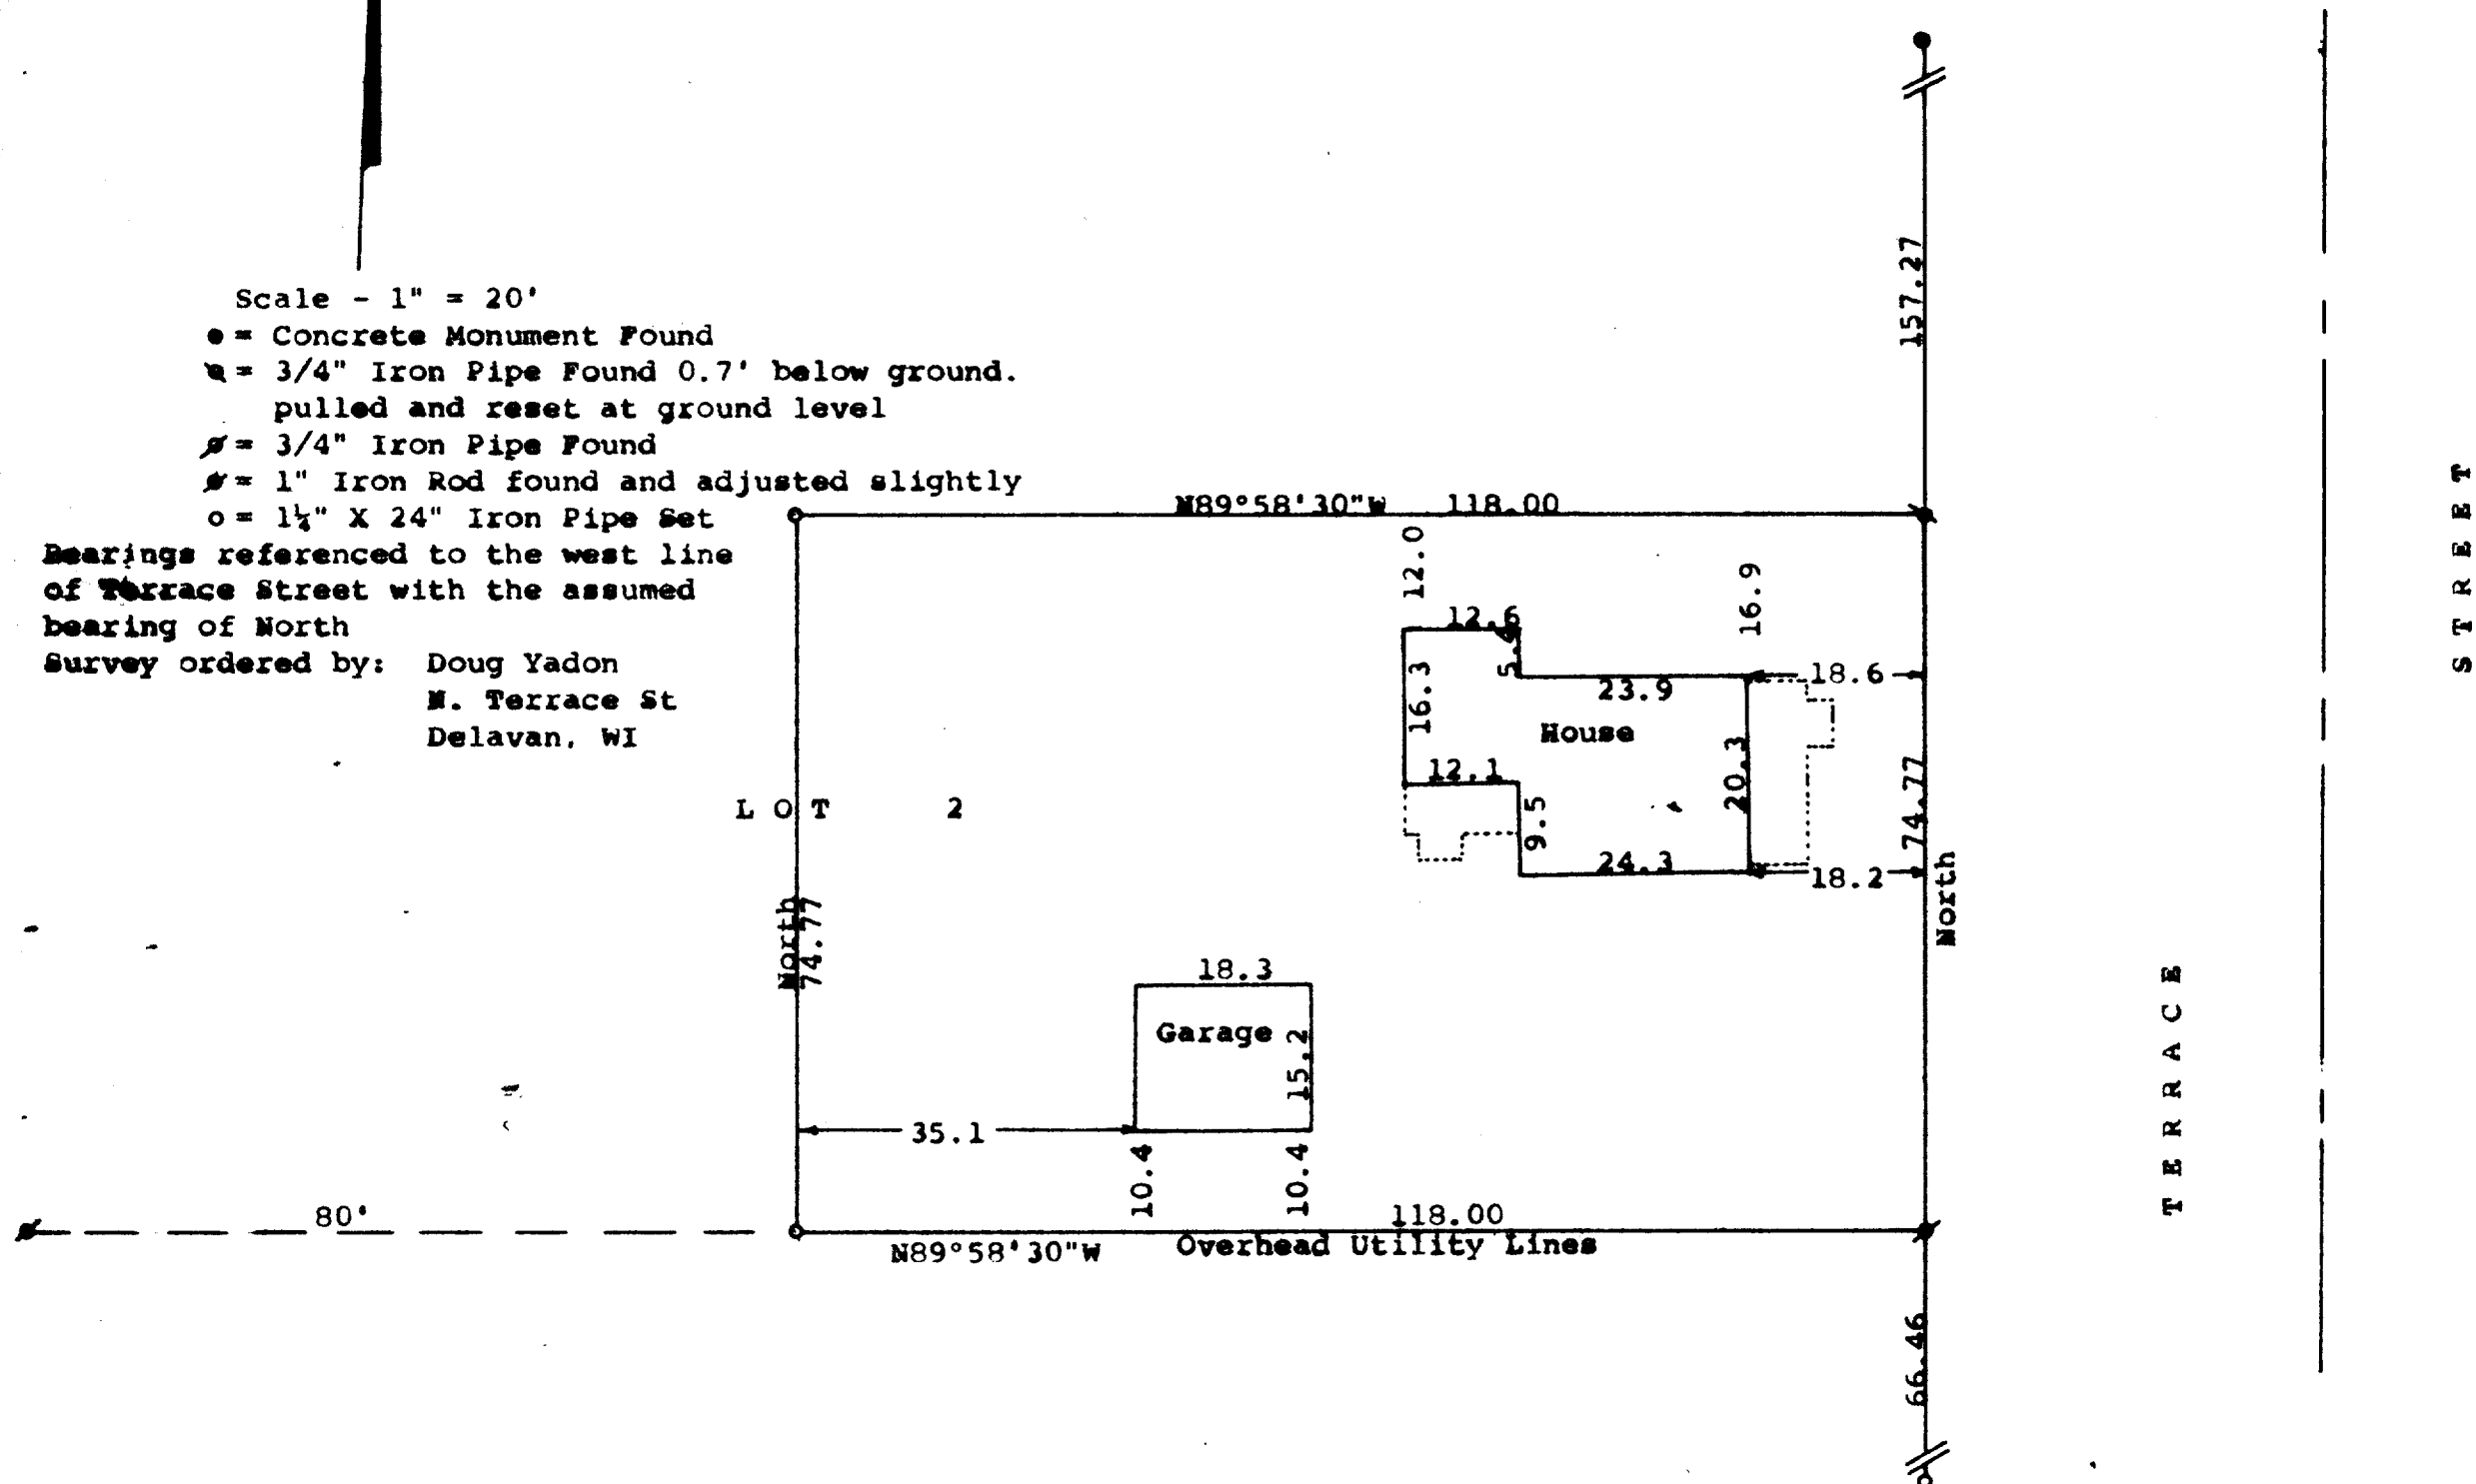

George T. Dunham  
George T. Dunham, Surveyor

