
## BUNNEYMO & MANDENING DELAVAN, WISCONSIN 53115

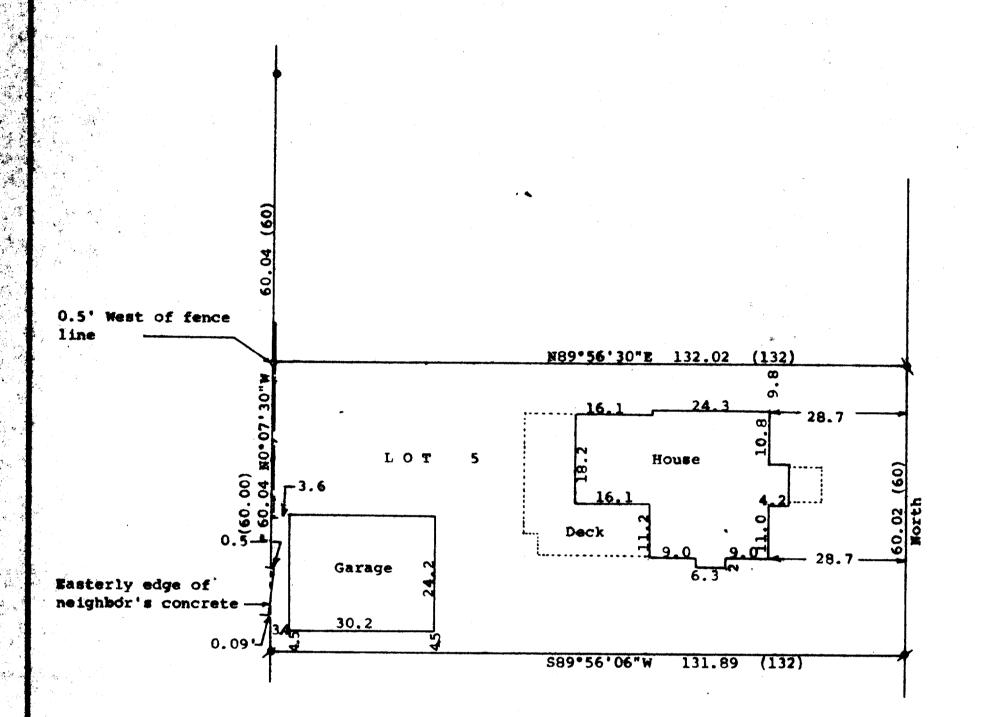

Scale - 1" = 20'

• = Concrete Monument Found # = 1" Iron Pipe Found N = 3/4" Iron Pipe Found 0 = ½" X 24" Iron Pipe Set -a---- Fence Line Bearings referenced to the west line of Elm Street with the assumed bearing of Survey ordered by Barb Schmaling

214 Elm Street Delavan, WI 53115 (0.00) = recorded distance

STATE OF WISCONSIN) SS COUNTY OF WALMORTH)

I, George T. Dunham, Surveyor, certify that I have surveyed the property described as follows:

Lot 5 in Block 1 of Sunset View Subdivision located in the City of Delavan, Walworth County, Wisconsin,

and that the plat shown hereon is a correct representation thereof and shows the size and location of the property, its exterior boundaries, the location of all visible structures and dimensions of all principal buildings thereon, boundary fences, apparent essements, roadways and visible encroachments, if any, and that I have surveyed the property hereon described, according to the official records, to the best of my knowledge and belief. August 24, 1990





No.