


ABELL  
SURVEYING & MAPPING  
DELAVAN, WISCONSIN 53115  
414-728-6737




PARISH STREET  
SEVENTH STREET

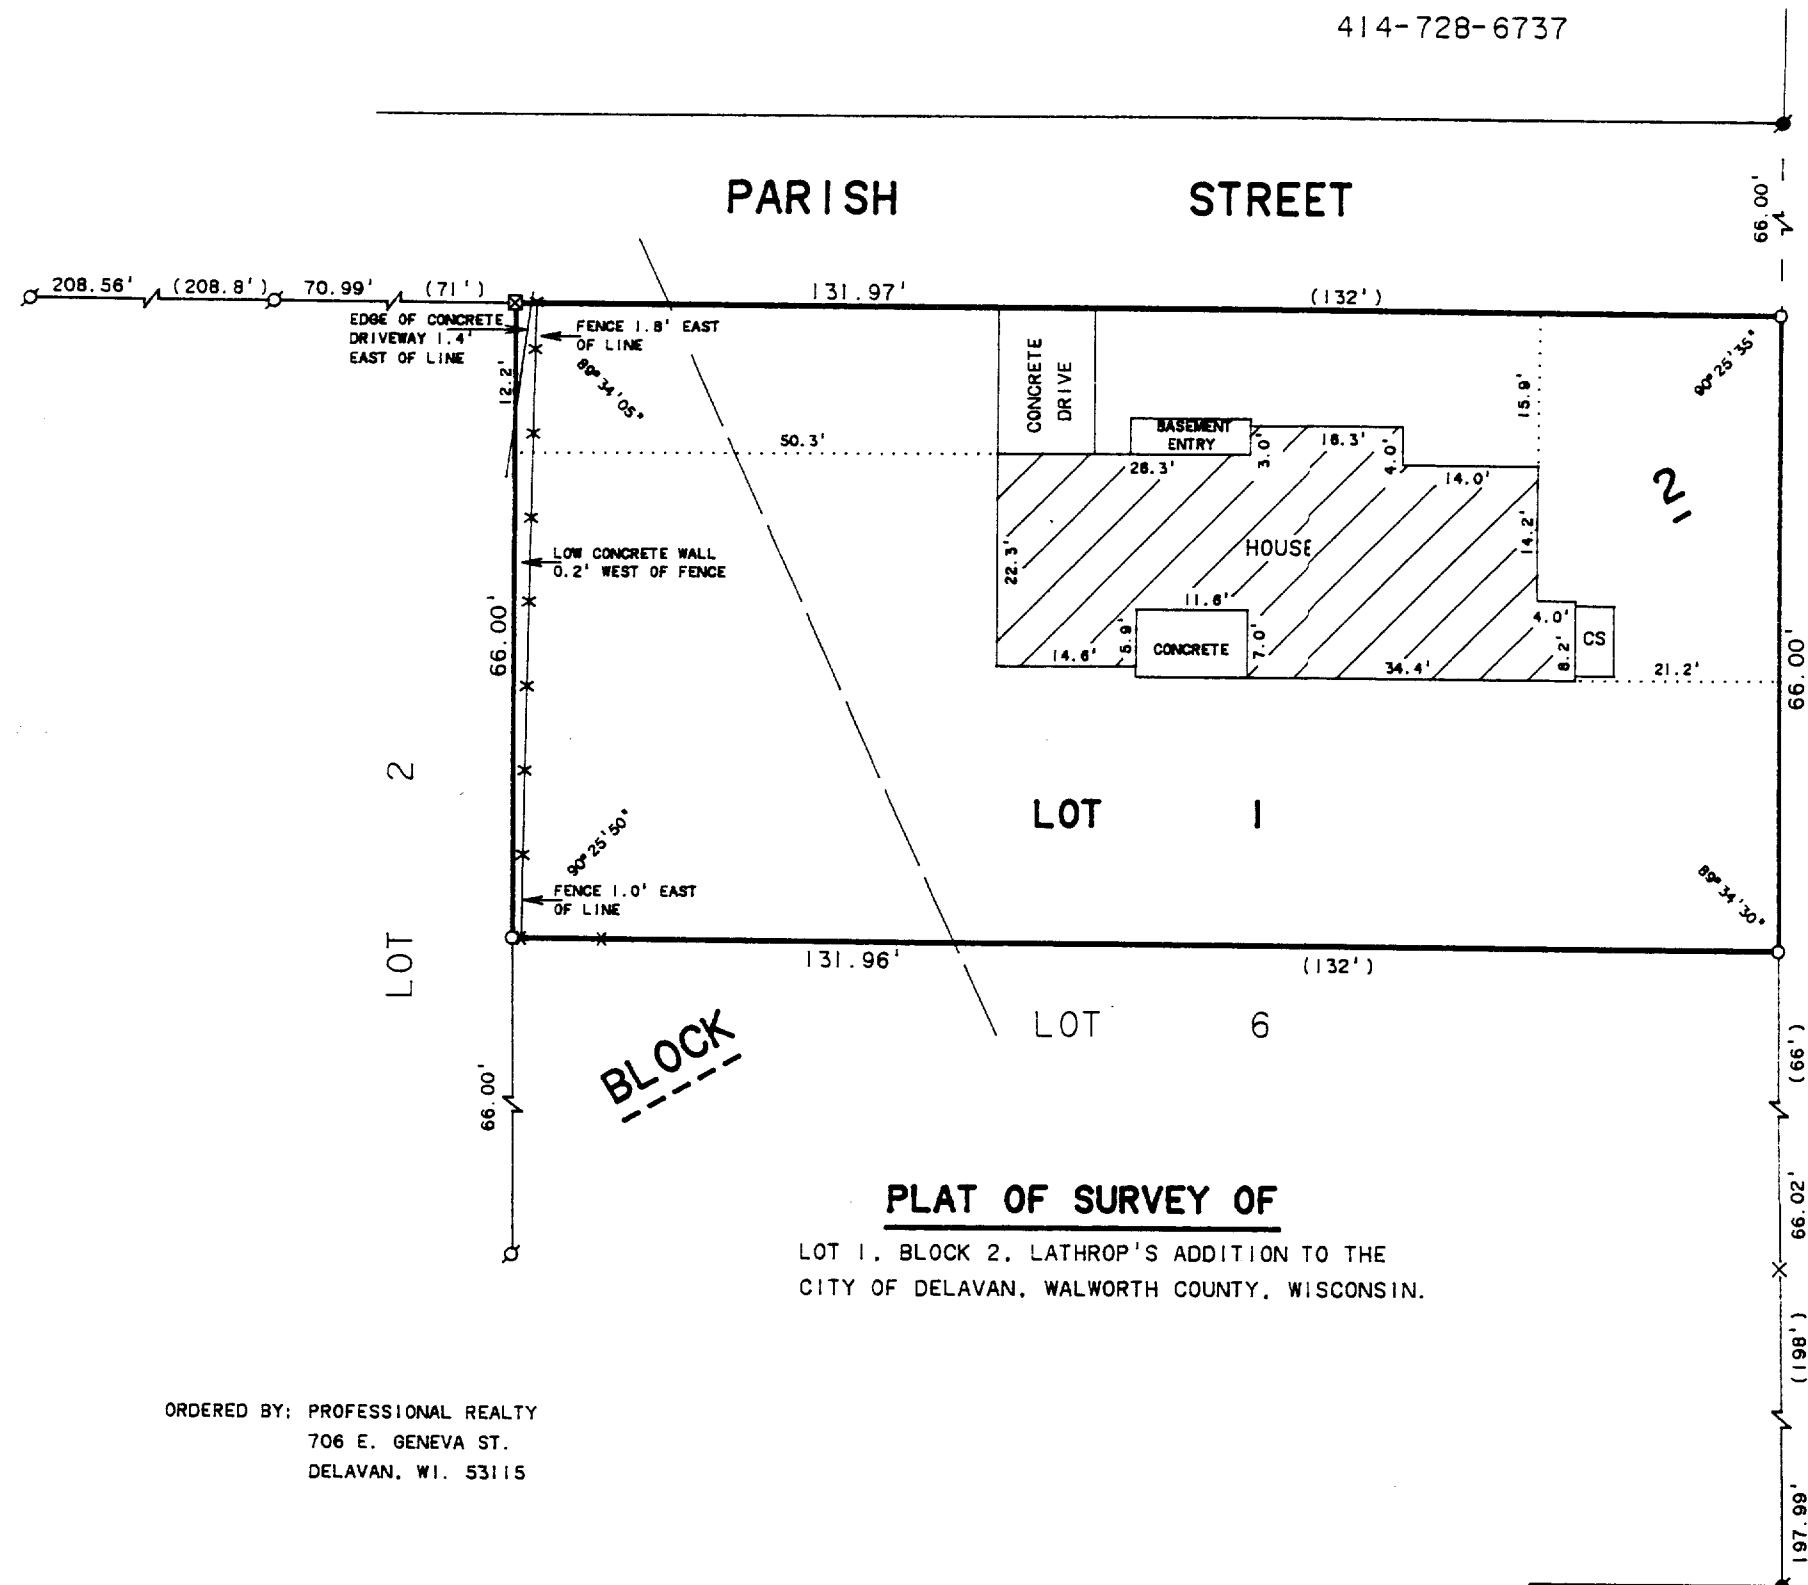

SCALE 1"=20'  
LEGEND

- Ø - IRON PIPE FOUND
- - CONCRETE MONUMENT FOUND
- X - CUT CROSS IN CONCRETE FOUND
- O - IRON PIPE SET
- ⊠ - CUT CROSS IN CONCRETE SET
- CS - CONCRETE STOOP
- \* - WIRE FENCE
- - OVERHEAD UTILITY LINES
- ( ) - RECORDED AS

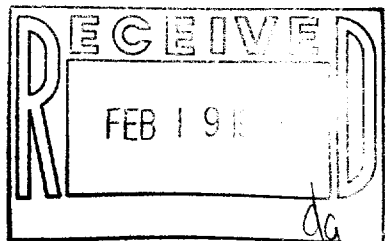

I HEREBY CERTIFY THAT I HAVE SURVEYED THE ABOVE DESCRIBED PROPERTY AND THAT THE ABOVE MAP IS A TRUE REPRESENTATION THEREOF AND SHOWS THE SIZE AND LOCATION OF THE PROPERTY, ITS EXTERIOR BOUNDARIES, THE LOCATION OF ALL VISIBLE STRUCTURES AND DIMENSIONS OF ALL PRINCIPAL BUILDINGS THEREON, BOUNDARY FENCES, APPARENT EASEMENTS, ROADWAYS AND VISIBLE ENCROACHMENTS, IF ANY, TO THE BEST OF MY KNOWLEDGE AND BELIEF.

THIS SURVEY IS MADE FOR THE USE OF THE PRESENT OWNERS OF THE PROPERTY, AND ALSO THOSE WHO PURCHASE, MORTGAGE, OR GUARANTEE THE TITLE THERETO WITHIN ONE (1) YEAR FROM DATE HEREOF.

*David F. Abell*

DAVID F. ABELL  
WISCONSIN REGISTERED LAND SURVEYOR, S-1596

*December 19, 1991*

DATE JOB NUMBER - 91267  
NOTE: THIS IS NOT A CERTIFIED COPY UNLESS SEALED.