
DELAVAN WISSONSN 53115

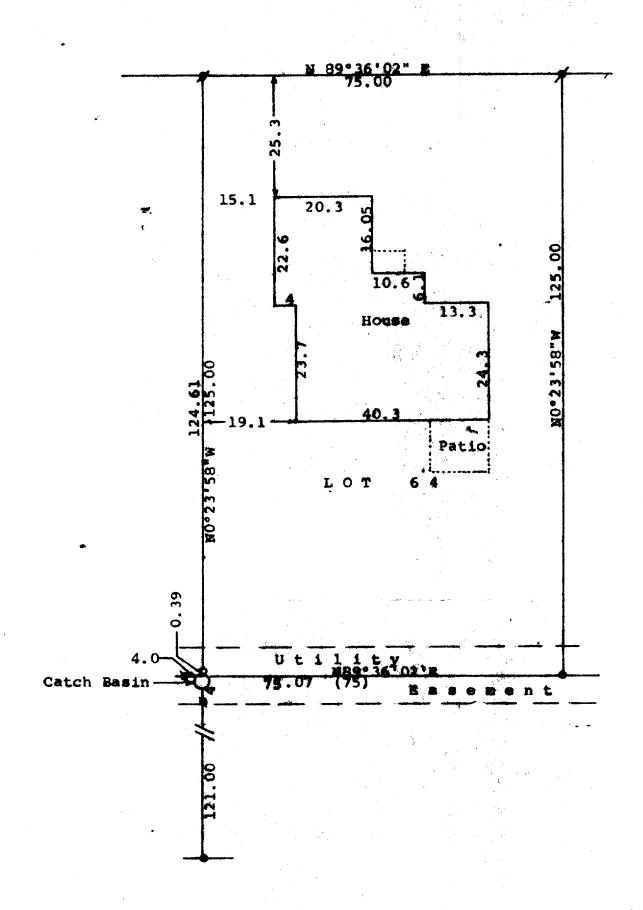

Scale - 1" = 20'= 5/8" Dia. Iron Rod Found ≠ 1" Iron Pipe Found □ = 3/4" Iron Pipe Found 0 = 3/4" X 24" Iron Pipe Set Bearings are those shown of the recorded plat of Turtle Creek Survey ordered by: Arleigh Aschebrook 433 Turtle Creek Drive Delavan, WI 53115 (0.00)= Recorded distance

STATE OF WISCONSIN) SS COUNTY OF WALMORTH)

I. George T. Dunham, Surveyor, certify that I have surveyed the property described as follows:

Lot 64 of Turtle Creek, a subdivision located inthe Southeast & of Section 13, 7.2 N, R 15 B, City of Delavan, Walworth County, Wisconsin and that the plat shown hereon is a correct representation thereof and shows the size and location of the property, its exterior boundaries, the location of all visible structures and dimensions of all principal buildings thereon, boundary fences, apparent easements, roadways and visible encroachments, if any, and that I have surveyed the property hereon described according to the official records, to the best of my knowledge and belief. October 24, 1990

George T. Dunham, Surveyor



