

ABELL SURVEYING & MAPPING

DELAVAN, WISCONSIN 53115

414-728-6737

CERTIFIED SURVEY MAP NO. 534



SCALE 1"=20'

LEGEND

- - IRON PIPE FOUND
- - IRON PIPE SET
- ⊙ - RR SPIKE SET
- CS - CONCRETE STOOP
- * - WOOD FENCE
- ** - WIRE FENCE
- () - RECORDED AS

LOT

19

LOT

20


PLAT OF SURVEY OF

THE EAST 33 FEET OF LOT 19 AND THE WEST 16 1/2 FEET OF LOT 20. BLOCK 2, ELMHURST SUBDIVISION, LOCATED IN THE CITY OF DELAVAN, WALWORTH COUNTY WISCONSIN.

BLOCK

BARNES STREET

NOTE: BEARINGS ARE REFERENCED TO
CERTIFIED SURVEY MAP NO. 534.

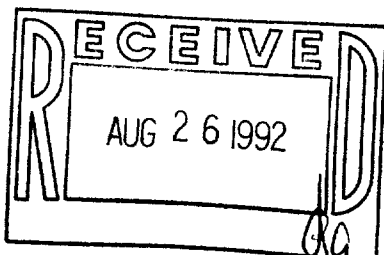

ORDERED BY: PROFESSIONAL REALTY
706 E. GENEVA ST.
DELAVAN, WI. 53115

I HEREBY CERTIFY THAT I HAVE SURVEYED THE ABOVE DESCRIBED PROPERTY AND THAT THE ABOVE MAP IS A TRUE REPRESENTATION THEREOF AND SHOWS THE SIZE AND LOCATION OF THE PROPERTY, ITS EXTERIOR BOUNDARIES, THE LOCATION OF ALL VISIBLE STRUCTURES AND DIMENSIONS OF ALL PRINCIPAL BUILDINGS THEREON, BOUNDARY FENCES, APPARENT EASEMENTS, ROADWAYS AND VISIBLE ENCROACHMENTS, IF ANY, TO THE BEST OF MY KNOWLEDGE AND BELIEF.

THIS SURVEY IS MADE FOR THE USE OF THE PRESENT OWNERS OF THE PROPERTY, AND ALSO THOSE WHO PURCHASE, MORTGAGE, OR GUARANTEE THE TITLE THERETO WITHIN ONE (1) YEAR FROM DATE HEREON.

David F. Abell

DAVID F. ABELL
WISCONSIN REGISTERED LAND SURVEYOR, S-1596

JULY 6, 1992

DATE

JOB NUMBER - 92152

NOTE: THIS IS NOT A CERTIFIED COPY UNLESS SEALED.

002-1162

XEA-17B