


DUNHAM SURVEYING, S. C.
 SURVEYING & SUBDIVIDING
 DELAVAN, WISCONSIN 53115

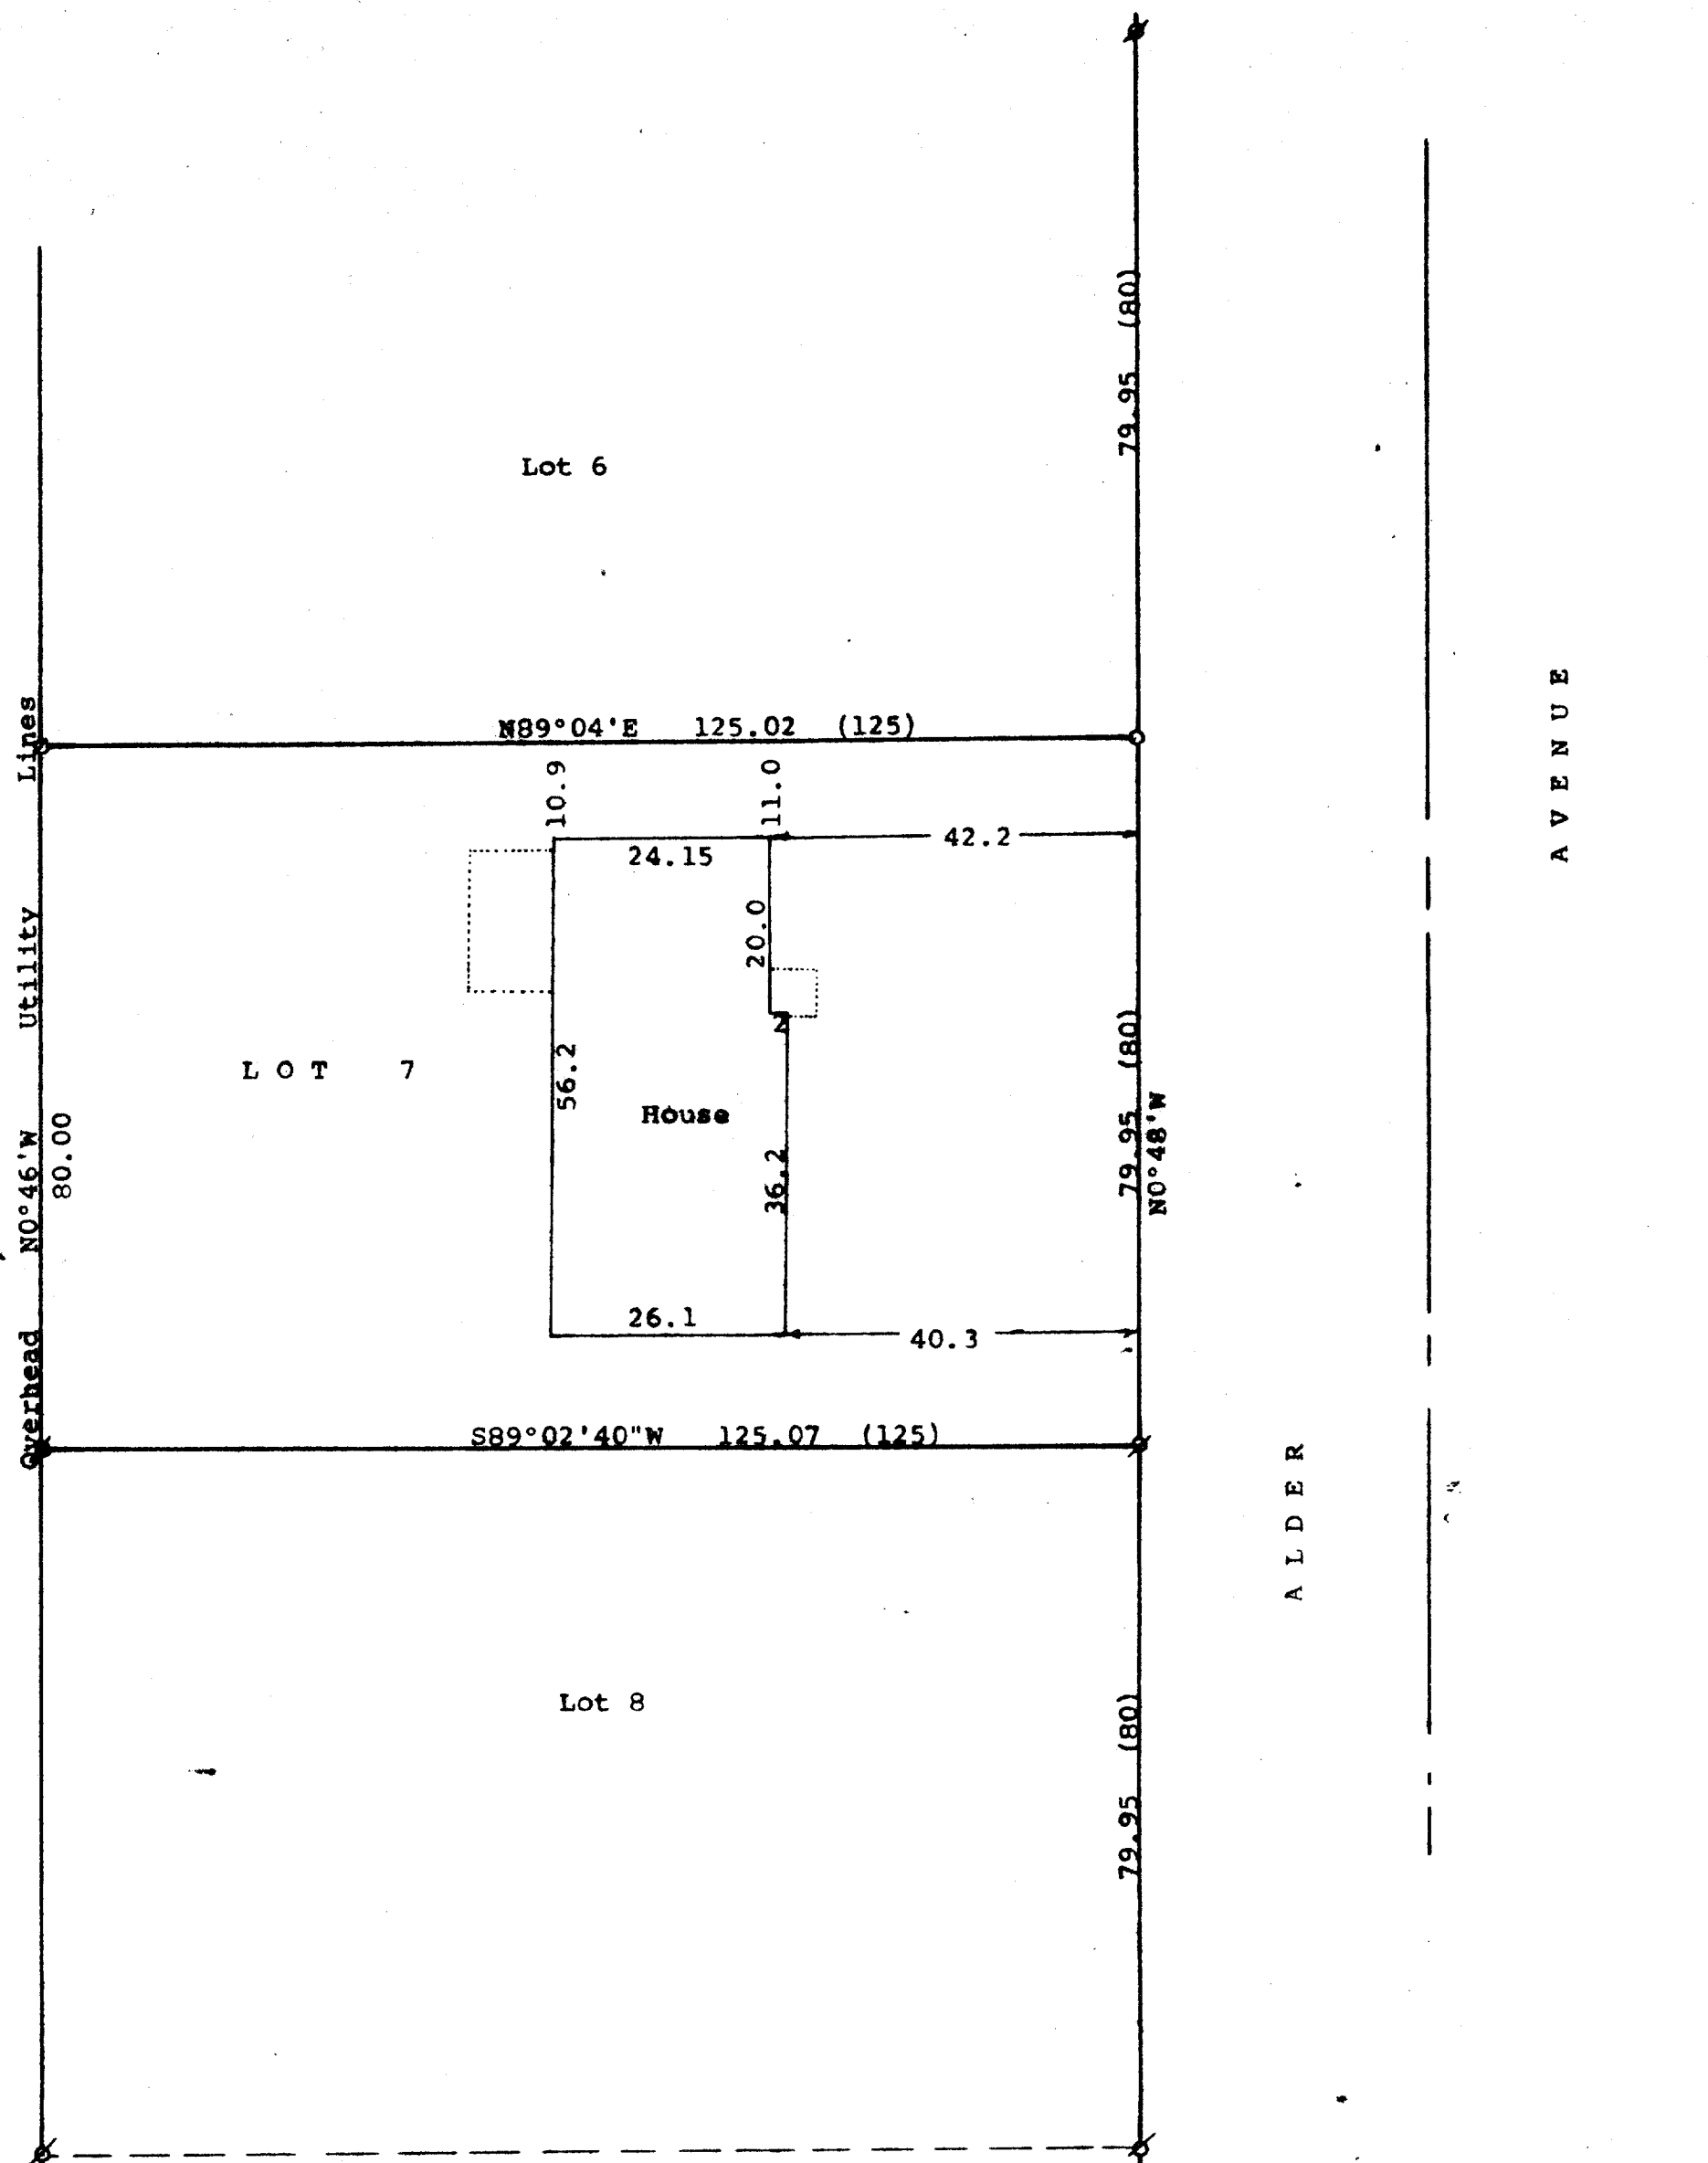

Scale - 1" = 20'
 ⌀ = 1" Iron Pipe Found
 ⚓ = 3/4" Iron Rod Found
 ○ = 1" X 24" Iron Pipe Set
 Bearings referenced to the west line of
 Alder Avenue with the recorded bearing
 of N0°48'W
 Survey ordered by:
 Century 21, Skandia Realty
 312 South 7th Street
 Delavan, WI 53115

STATE OF WISCONSIN) SS
 COUNTY OF WALWORTH) SS
 I, George T. Dunham, Surveyor, certify that I have surveyed the property
 described as follows:
 Lot 7 in Block 3 of Allynhurst Subdivision located in the City of Delavan,
 Walworth County, Wisconsin, subject to easements of record,
 and that the plat shown hereon is a correct representation thereof and shows
 the size and location of the property, its exterior boundaries, the location
 of all visible structures and dimensions of all principal buildings thereon,
 boundary fences, apparent easements, roadways and visible encroachments, if
 any, and that I have surveyed the property hereon described, according to the
 official records, to the best of my knowledge and belief.
 October 26, 1992

George T. Dunham
 George T. Dunham, Surveyor

