
MARINO

AVENUE

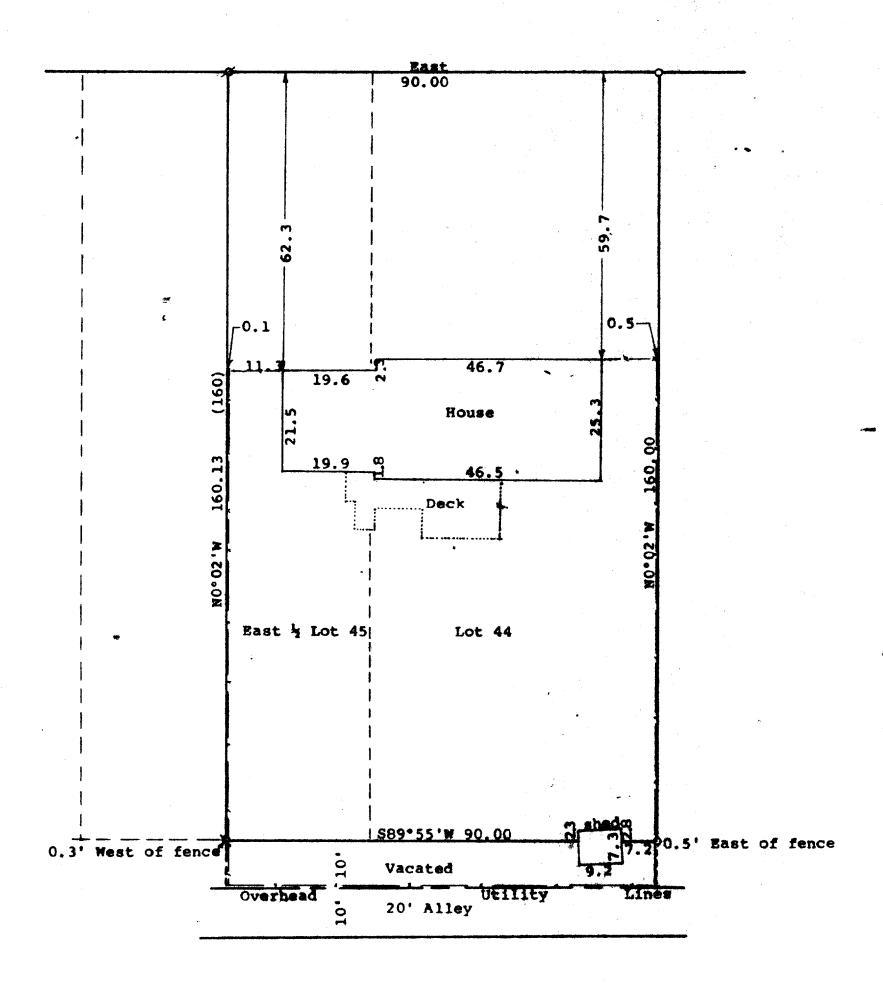

Scale - 1" = 20# = 1%" Iron Pipe Found 0 = 1" Iron Pipe Found Q = 3/4" Iron Pipe Found

-/-- Fence Line Bearings referenced to the south line of Marino Avenue with the assumed bearing of Bast Survey ordered by: Realty World, Carmin Realtors 811 East Geneva St Delavan, WI 53115

STATE OF WISCONSIN) SS

COUNTY OF WALWORTH)

I, George T. Dunham, Surveyor, certify that I have surveyed the property described as follows:

Lot 44 and the East 4 of Lot 45 of Mar-Del Estates, a subdivision

located in the City of Delavan, Walworth County, Wisconsin. and that the plat shown hereon is a correct representation thereof and shows the size and location of the property, its exterior boundaries, the location of all visible structures and dimensions of all principal buildings thereon, boundary fences, apparent easements, roadways and visible encroachments, if any, and that I have surveyed the property hereon described, according to the official records, to the best of my knowledge and belief. May 21, 1992

FEB | 11993

CEIVE

George T. Dunham, Surveyor

