


STREET

SIXTH

610

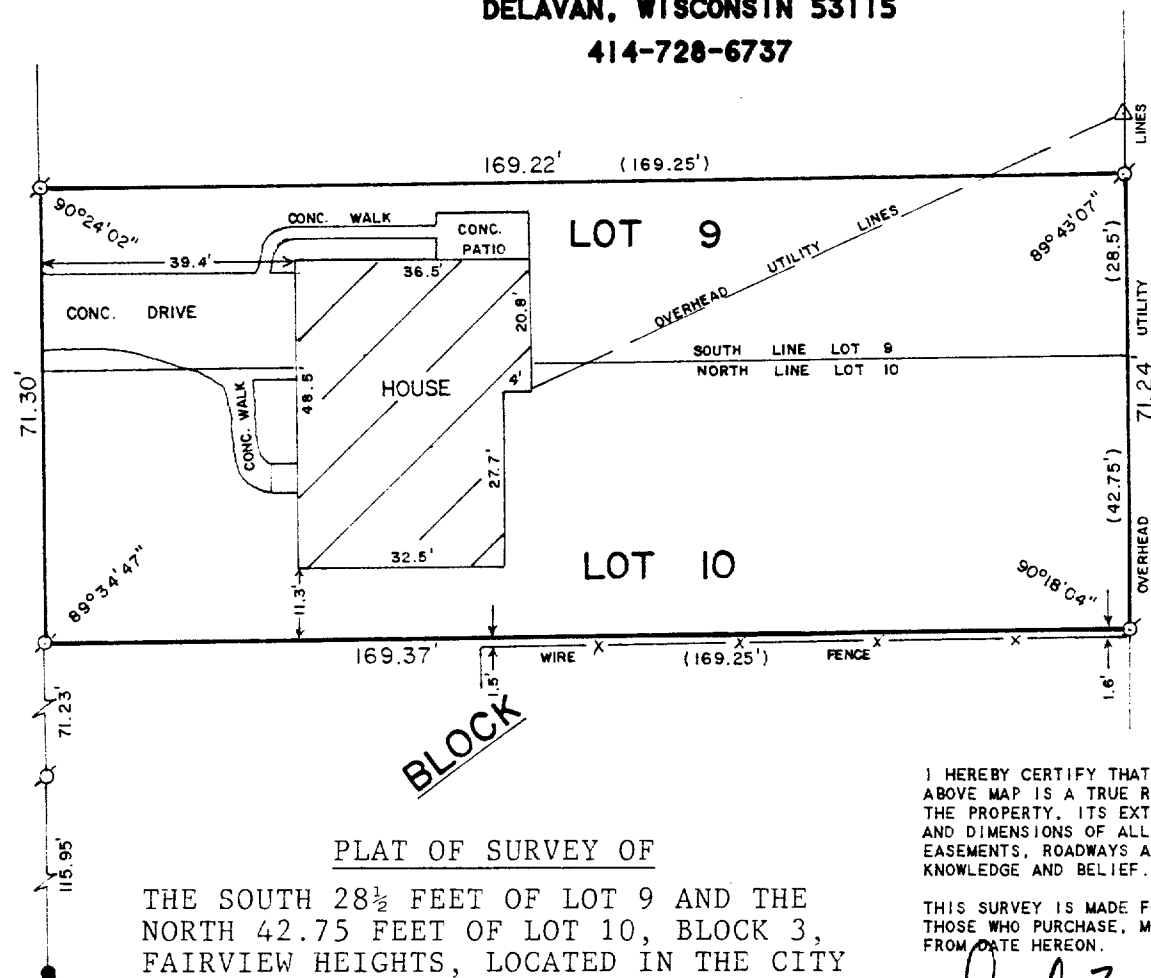

ORDERED BY: CENTURY 21 - SKANDIA REALTY
312 S. 7th STREET
DELAN, WI 53115

THIS SURVEY IS MADE FOR THE USE OF THE PRESENT OWNERS OF THE PROPERTY, AND ALSO THOSE WHO PURCHASE, MORTGAGE, OR GUARANTEE THE TITLE THERETO WITHIN ONE (1) YEAR FROM DATE HEREON.

DAVID F. ABELL
WISCONSIN REGISTERED LAND SURVEYOR, S-1596


DATE May 5, 1993 JOB NUMBER - 93086
NOTE: THIS IS NOT A CERTIFIED COPY UNLESS SEALED.



SCALE - 1"=30'

LEGEND

- ✂ - IRON PIPE FOUND
 △ - POWER POLE
 () - RECORDED AS
 ● - CONCRETE MONUMENT
 FOUND

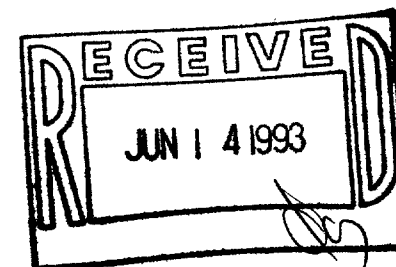

XFH-29

002-1257