
ABELL SURVEYING & MAPPING DELAVAN, WISCONSIN 53115 414-728-6737

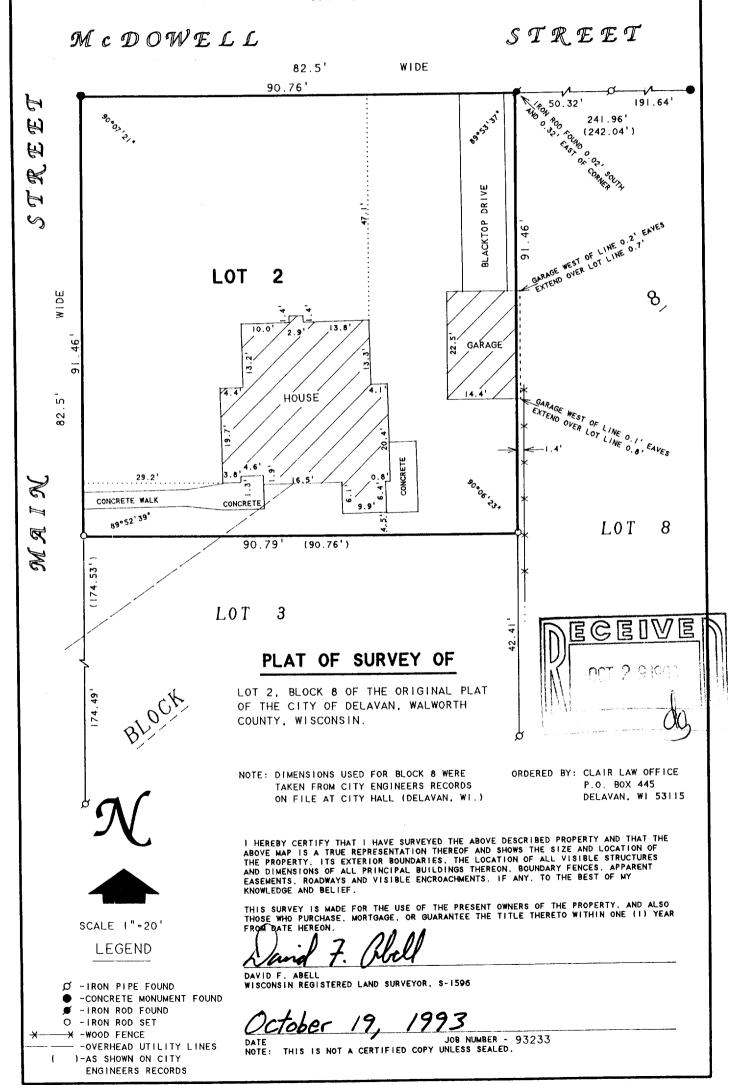

XOP-43

ØØ2-130Ø