
ABELL SURVEYING & MAPPING DELAVAN, WISCONSIN 53115 414-728-6737

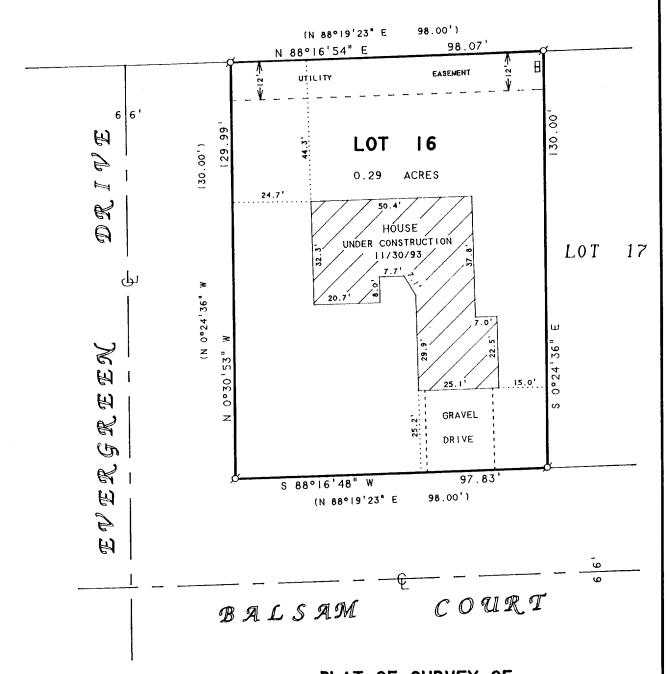

ORDERED BY: CECILIA SCHMIDT 120 BELOIT STREET

PLAT OF SURVEY OF

LOT 16, WHISPERING PINES, LOCATED IN THE CITY OF DELAVAN, WALWORTH

NOTE: BEARINGS ARE REFERENCED TO THE RECORDED SUBDIVISION PLAT.

DELAVAN, WI. 53115







SCALE | "=30"

LEGEND

Ø -IRON PIPE FOUND)-RECORDED AS

I HEREBY CERTIFY THAT I HAVE SURVEYED THE ABOVE DESCRIBED PROFESTY AND THAT THE ABOVE MAP IS A TRUE REPRESENTATION THEREOF AND SHOWS THE SIZE AND LOCATION OF THE PROPERTY. ITS EXTERIOR BOUNDARIES. THE LOCATION OF ALL VISIBLE STRUCTURES AND DIMENSIONS OF ALL PRINCIPAL BUILDINGS THEREON, BOUNDARY FENCES. APPARENT EASEMENTS, ROADWAYS AND VISIBLE ENCROACHMENTS. IF ANY, TO THE BEST OF MY KNOWLEDGE AND BELIEF.

THIS SURVEY IS MADE FOR THE USE OF THE PRESENT OWNERS OF THE PROPERTY. AND ALSO THOSE WHO PURCHASE. MORTGAGE. OR GUARANTEE THE TITLE THERETO WITHIN ONE (I) YEAR FROM DATE HEREON.

DAVID F. ABELL WISCONSIN REGISTERED LAND SURVEYOR, S-1596

REVISED DATE DECEMBER 1, 1993

JAN 2 6 1994

JOB NUMBER - 93/49
THIS IS NOT A CERTIFIED COPY UNLESS SEALED.