FARRIS, HANSEN & COOPER, INC.


ENGINEERING, BURWEYING AND LAND PLANNING 718 W WALWORTH ST. - P.O. BOX 487 - ELKHORN, WI 53121 OFFICE: 414/723-2098 DANIEL D. COOPER ROBERT A. FARRIS LAND SURVEYOR

EMBINEERING
MUNICIPAL - STRUCTURAL
MIGHWAYS - PUBLIC WORKS

WARREN E. HANSEN

PROFESSIONAL ENGINEER

SURVEYING & PLANNING
SUBDIVISIONS - LOT SURVEYS
CONSTRUCTION STAKING - MAPPING

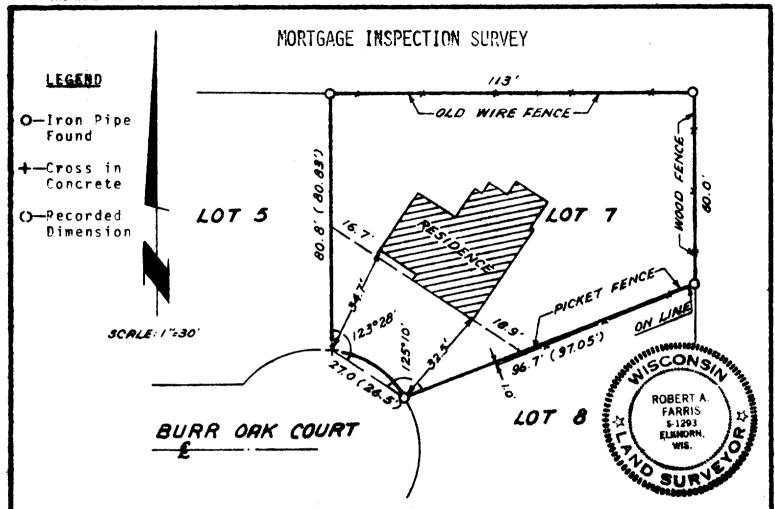

LOT 7 OF BURR OAK SUBDIVISION, CITY OF DELAVAN, WALWORTH COUNTY, WIS.

LOCATION: 7 Burr Oak Court

Delavan, Wis.

SELLER: Joseph A. Steen

ORDERED BY: Waukesha Savings

and Loan Assn.

BUYERS: David K. and Carol R.

0'Dell

NOTE: THIS IS NOT A "PROPERTY SURVEY" AS DEFINED IN SEC. A-E 5.01

OF THE WISCONSIN ADMINISTRATIVE CODE.

I hereby certify that this map is a true and accurate representation of the lines described and the location of the buildings thereon to the best of my knowledge and belief.

Robert A. Farris

Wis. Reg. Surveyor S-1293

Date