


**ABELL
SURVEYING & MAPPING
DELAVER, WISCONSIN 53115
414-728-6737**

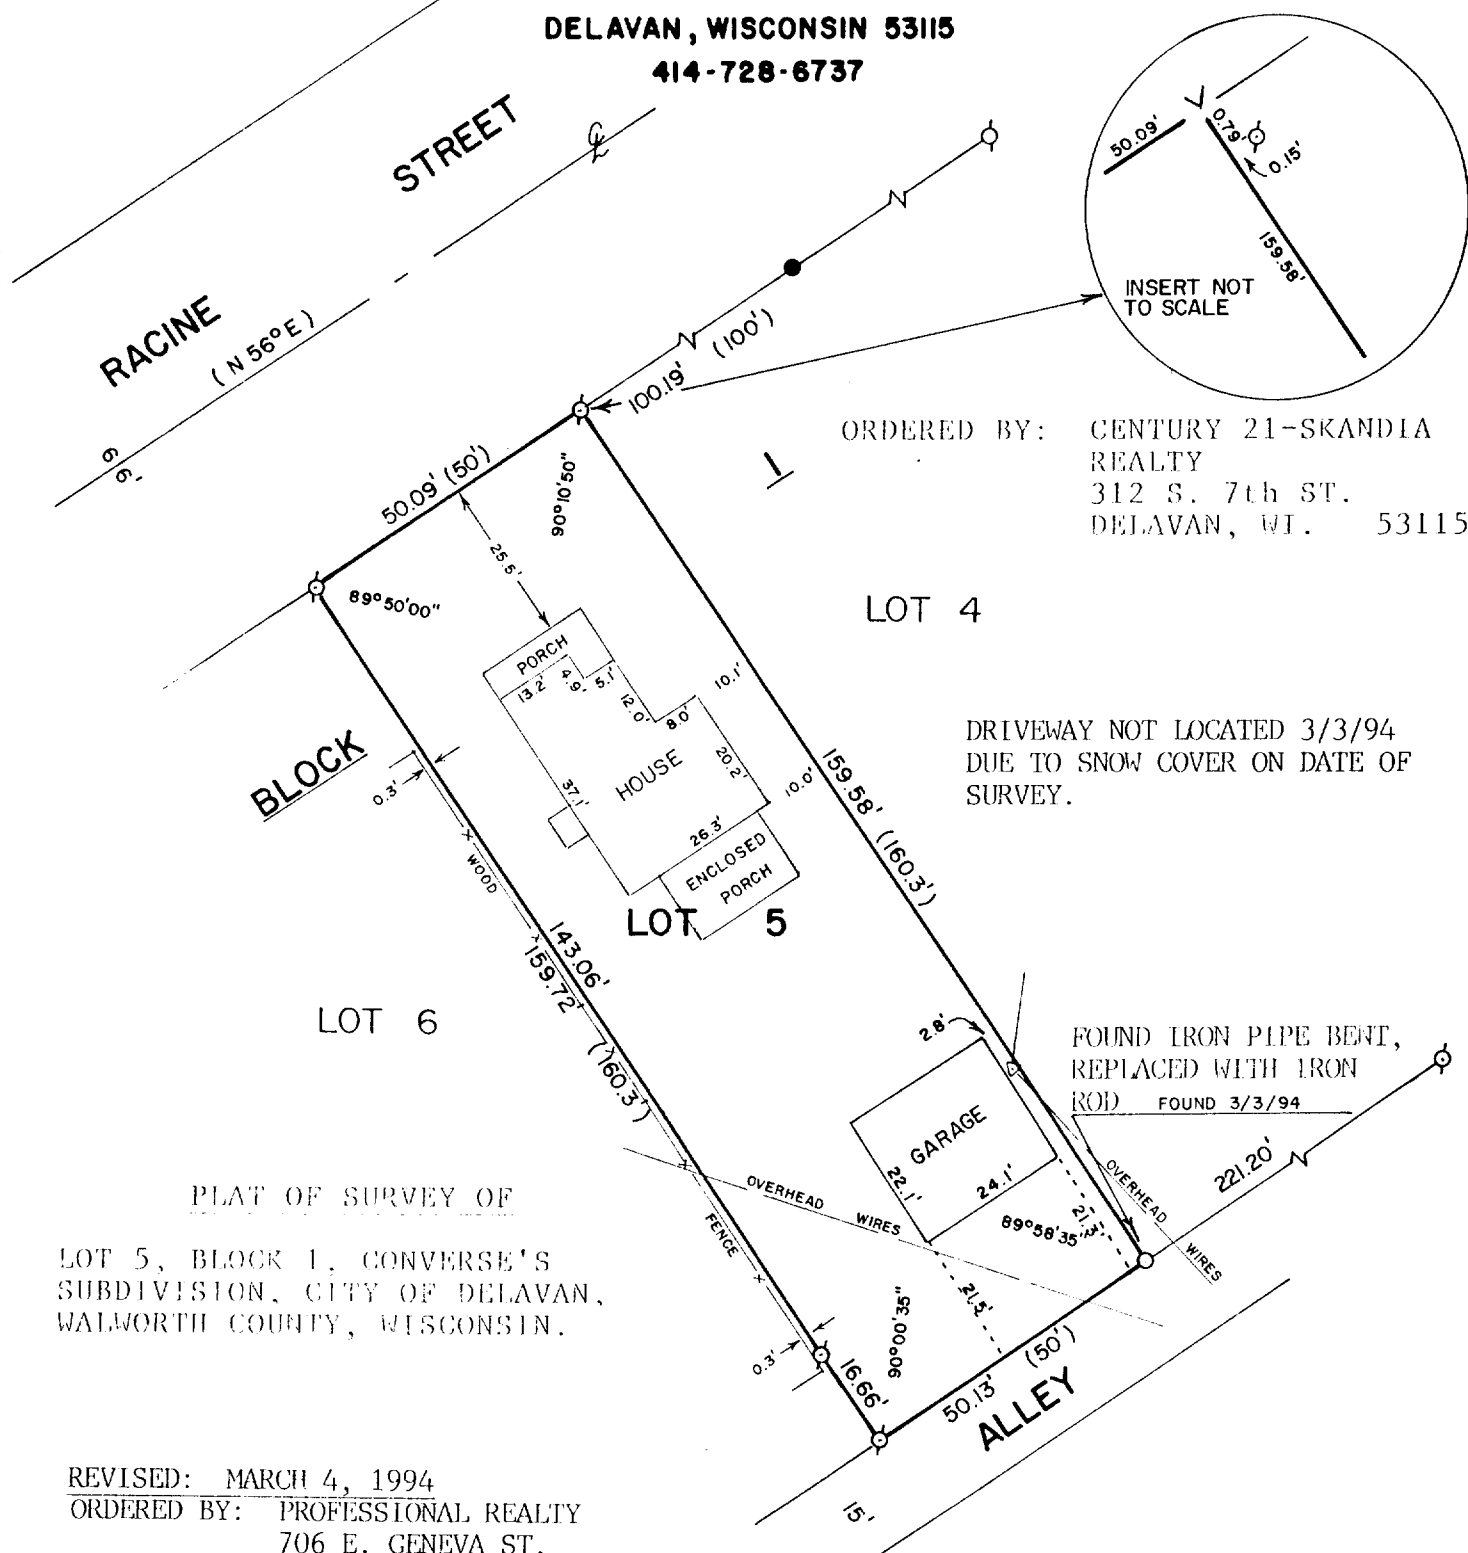

SCALE - 1"=30'

LEGEND

- ⊗ - IRON PIPE FOUND
- - 3/4" DIA. IRON ROD SET
- - IRON ROD FOUND
- () - RECORDED AS
- ✓ - CUT V IN CONCRETE
SIDEWALK FOUND 3/3/94
- △ - UTILITY POLE

I, DAVID F. ABELL, DO HEREBY CERTIFY
THAT I HAVE SURVEYED THE PROPERTY
HEREON DESCRIBED ACCORDING TO THE
OFFICIAL RECORDS AND THAT THE PLAT
HEREON IS A CORRECT REPRESENTATION
OF THE PROPERTY LINES TO THE BEST OF
MY KNOWLEDGE AND BELIEF.

David F. Abell

DAVID F. ABELL
WISCONSIN REGISTERED LAND SURVEYOR, S-1596

October 26, 1987 REVISED: 3/4/94
DATE JOB NUMBER - 87163

NOTE: THIS IS NOT A CERTIFIED COPY UNLESS SEALED.

XCS-4

002-1353