



McDowell

Street

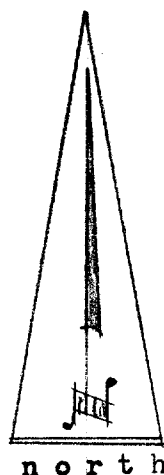

• Iron Stake.

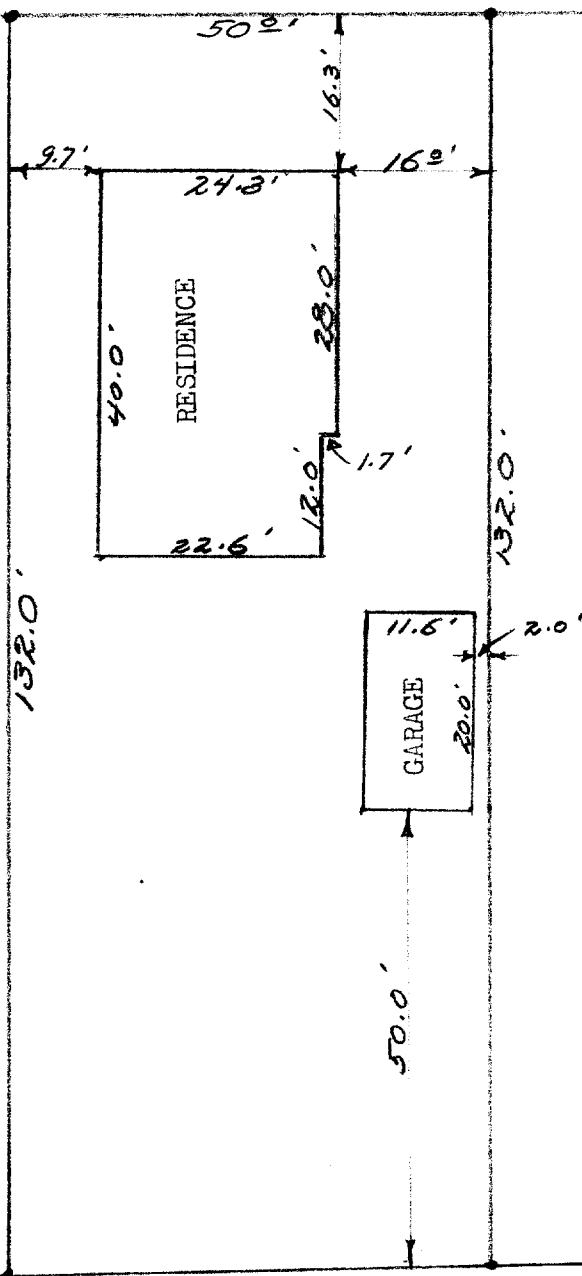

DESCRIPTION: The East 50 feet of the North 132 feet of Lot 8 Block 8, Original Plat of Delavan, in the City of Delavan, Walworth County, Wisconsin.

CERTIFICATE: I hereby certify that I have surveyed the above mentioned property and that the hereon portrayed is an accurate survey and a true representation thereof and correctly shows the exterior boundary lines and the location of the buildings and other improvements thereof.

May 10th 1966.

James F. Biagi, RLS 272
Elkhorn, Wisconsin.