


DUNHAM SURVEYING, S.C.  
SURVEYING & READING  
DELAVER, WISCONSIN 53115

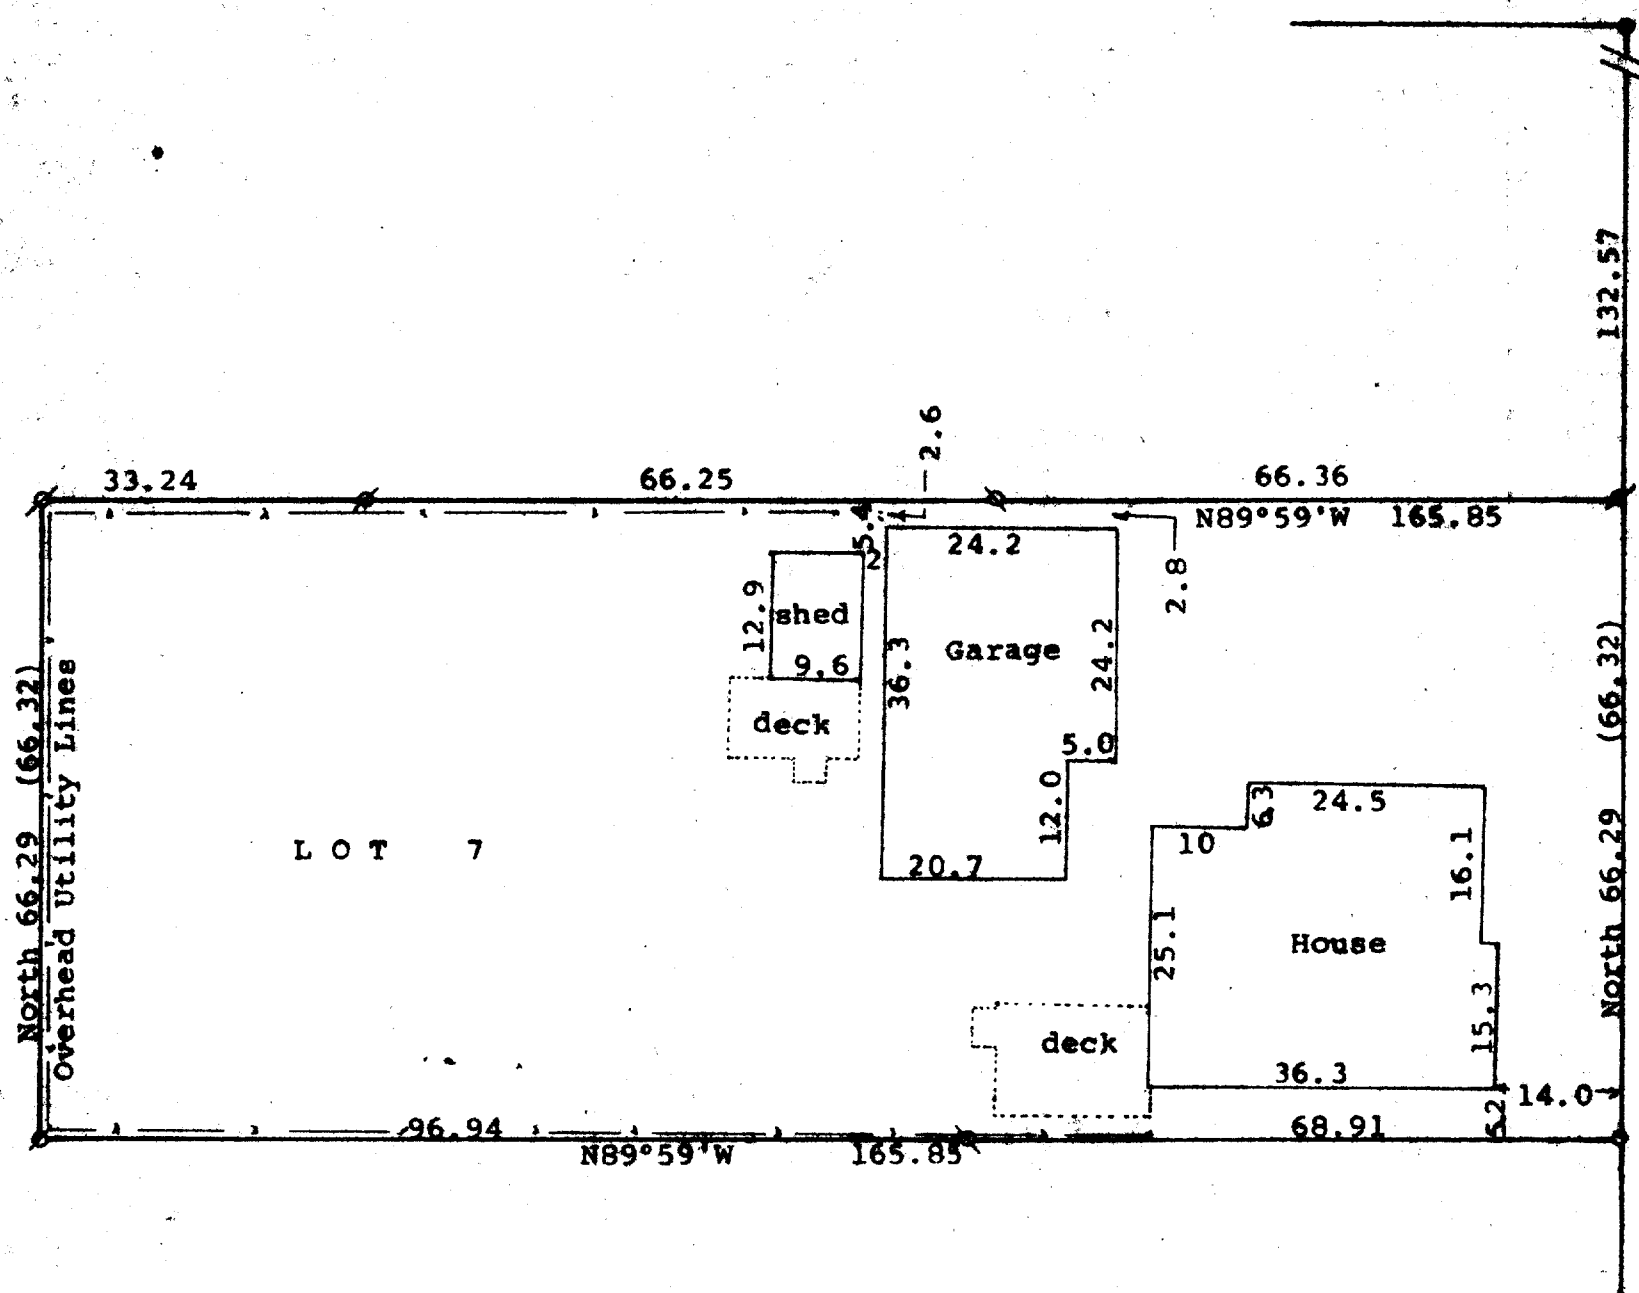

STREET

F I F T H

N

Scale - 1" = 20'

- = Concrete Monument
- ⊘ = 3/4" Iron Pipe Found
- ⊘ = 1 1/4" Iron Pipe Found
- = 1" Iron Pipe Found

(0.00) = recorded distance  
--- = Fence Line

Bearings referenced to the west line of Fifth Street with the assumed bearing of North



Survey ordered by:  
Century 21, Skandia Realty  
312 South 7th Street  
Delavan, WI 53115

STATE OF WISCONSIN) ss  
COUNTY OF WALWORTH)

I, George T. Dunham, Surveyor, certify that I have surveyed the property described as follows:

Lot 7 in Block 3 of Passage, Aram and Downie Addition to the City of Delavan, Walworth County, Wisconsin and that the plat shown hereon is a correct representation thereof and shows the size and location of the property, its exterior boundaries, the location of all visible structures and dimensions of all principal buildings thereon, boundary fences, apparent easements, roadways and visible encroachments, if any, and that I have surveyed the property hereon described, according to the official records, to the best of my knowledge and belief.  
August 17, 1994

*George T. Dunham*  
George T. Dunham, Surveyor

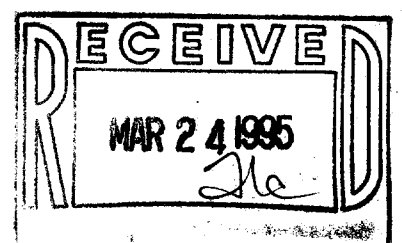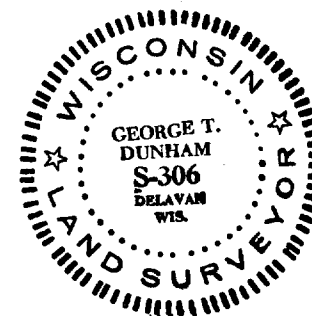

XP-34

002-1406