

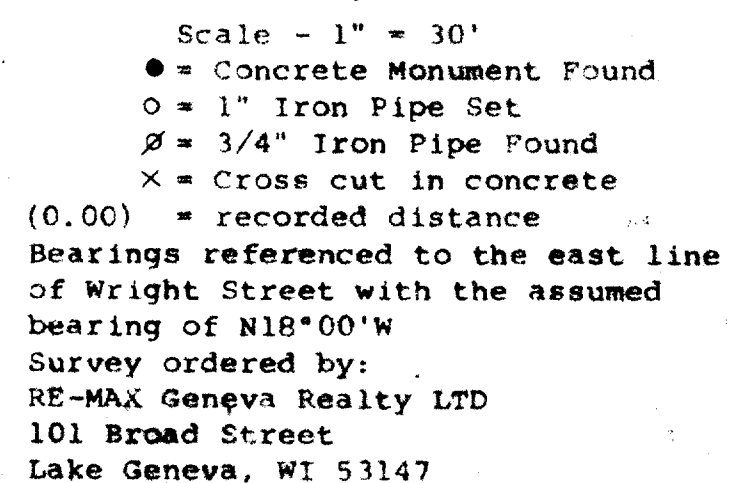


**SURVEYING & SUBDIVIDING**  
**DEHAVAN, WISCONSIN 53115**

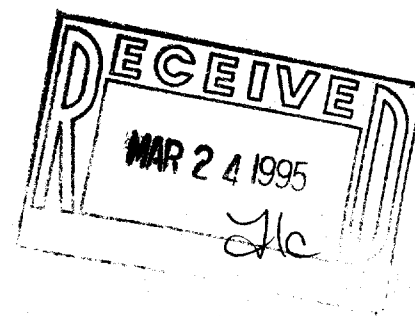

George F. Dunham  
George F. Dunham, Surveyor

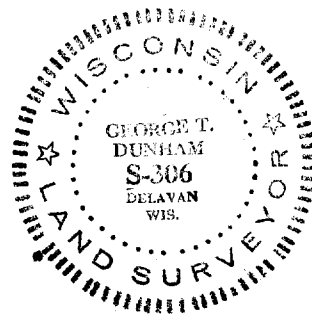

XD-18  
XD-18A  
XD-20

002-1418