


**DUNHAM SURVEYING, S.C.**  
 SURVEYING & SUBDIVIDING  
 DELAVAN, WISCONSIN 53115



N

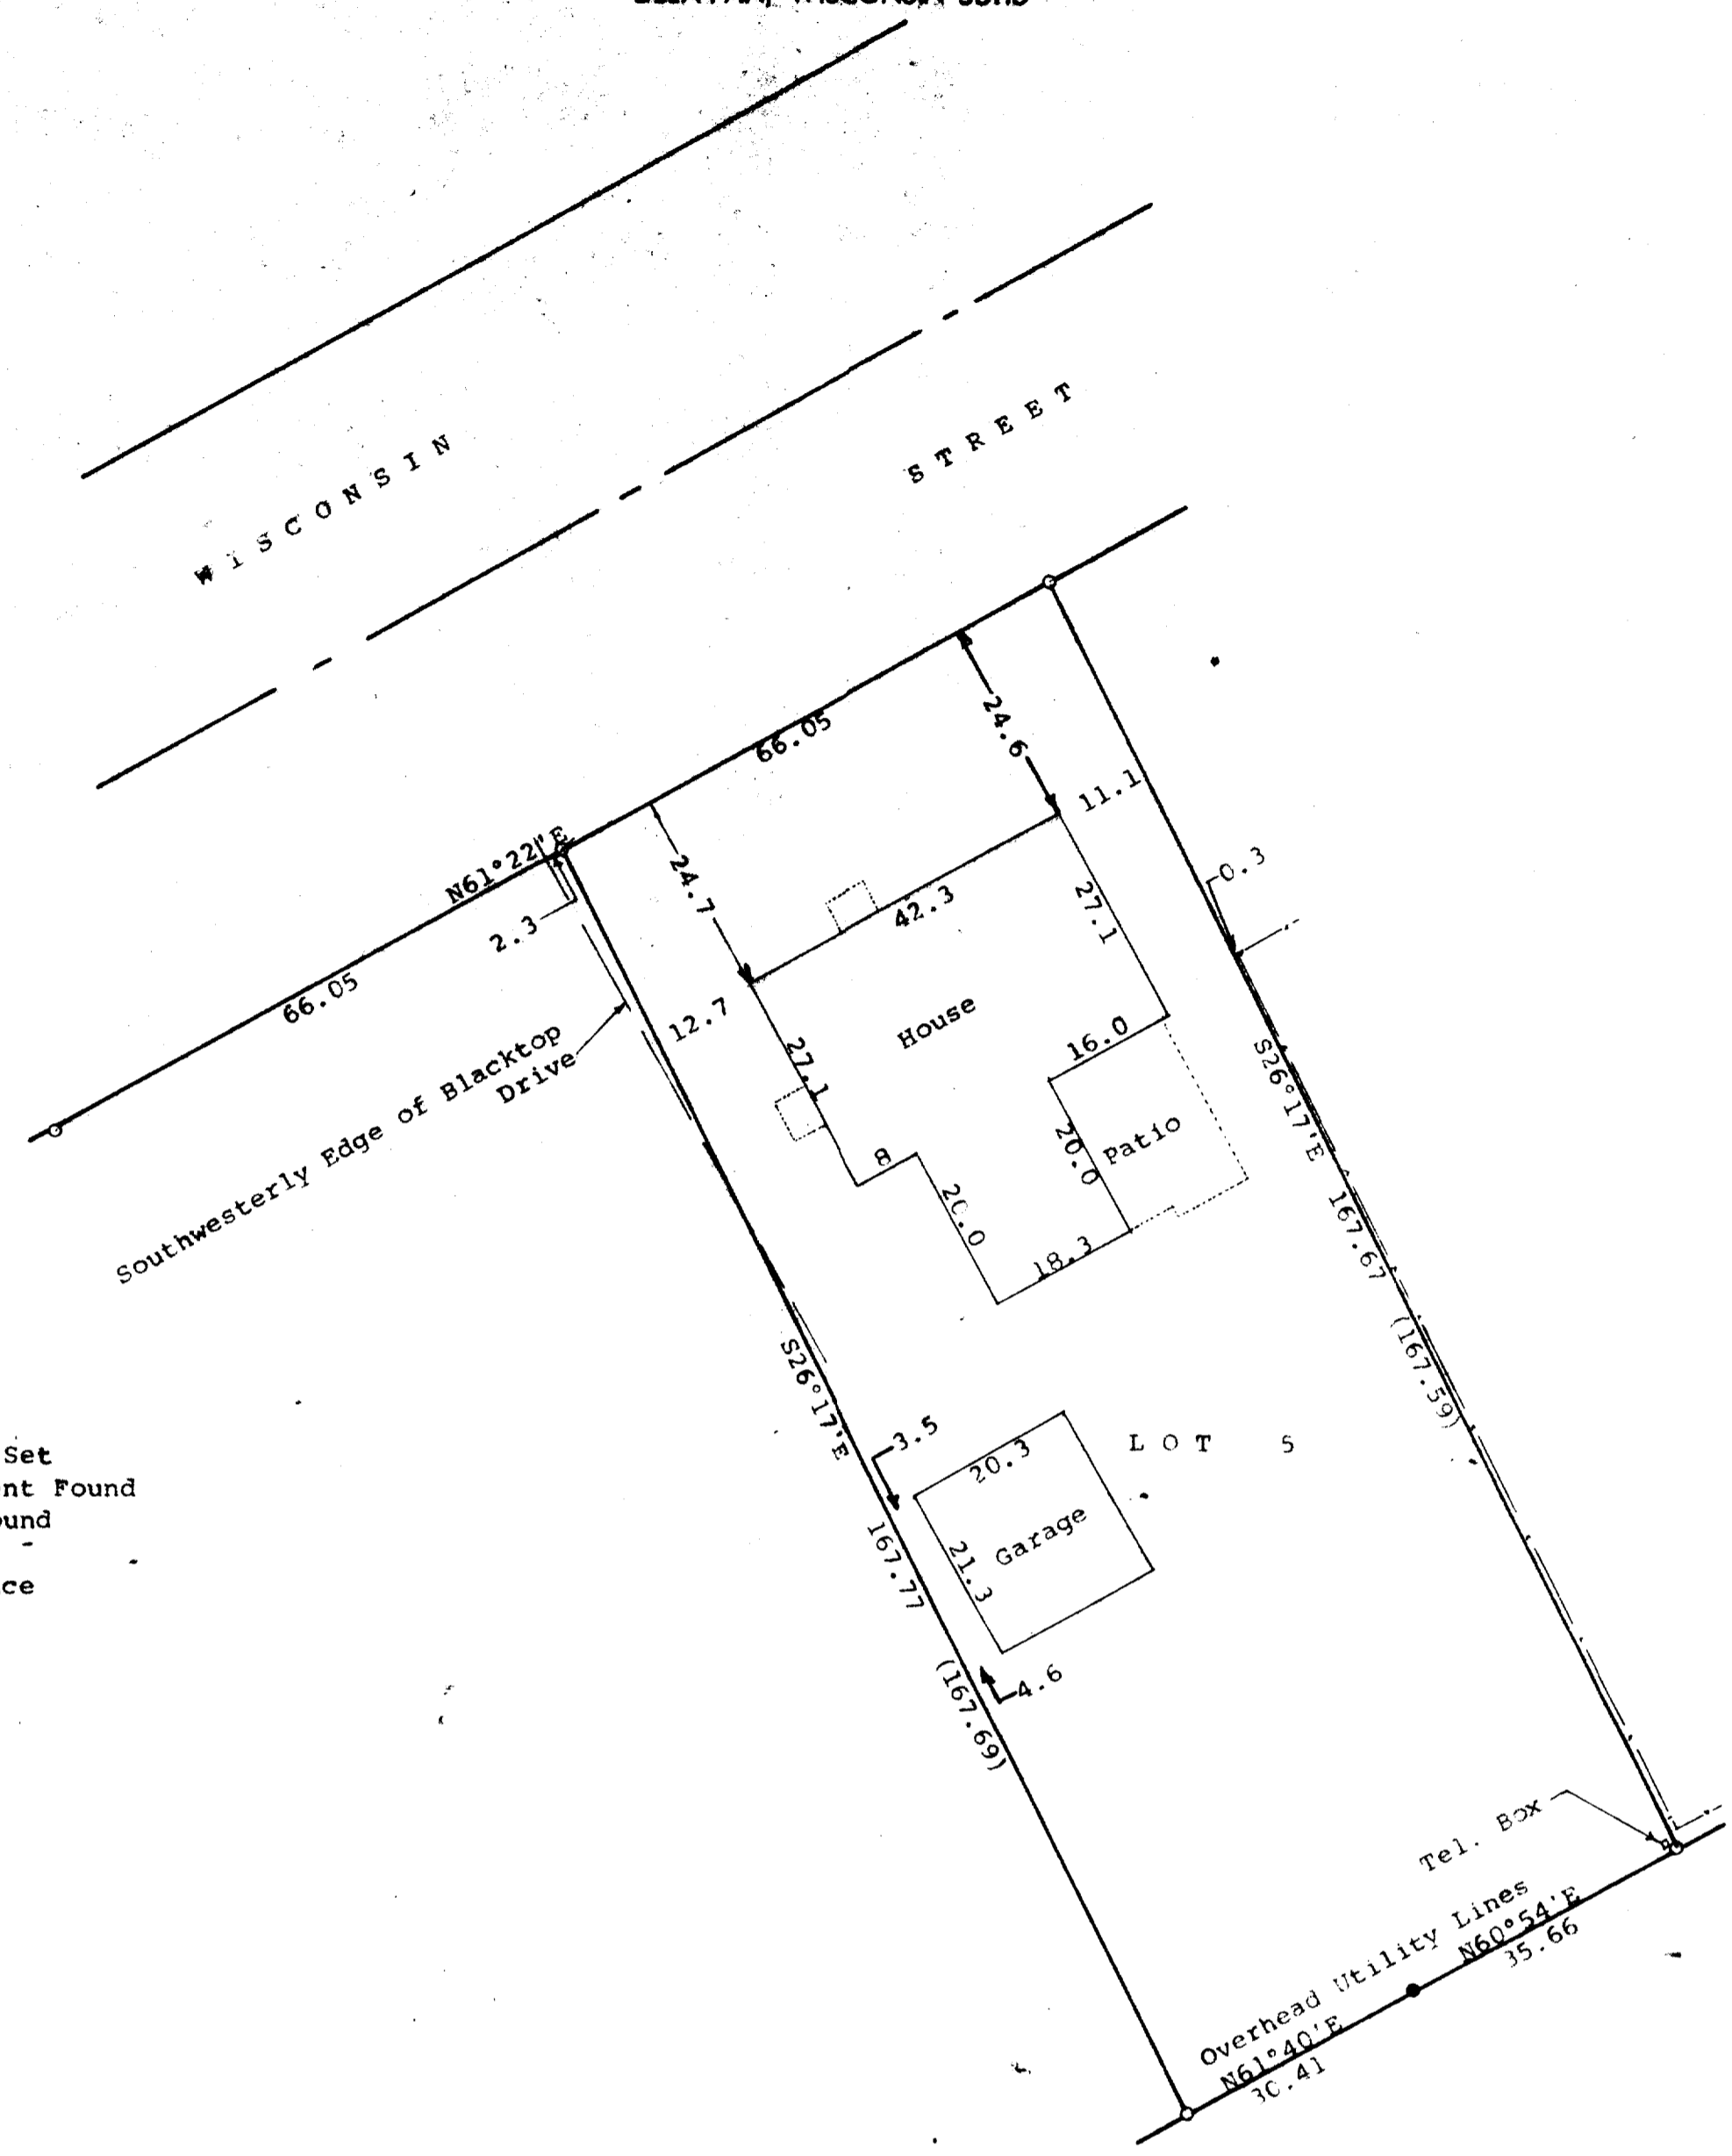

Scale - 1" = 20'  
 ∅ = 3/4" Iron Pipe Set  
 ● = Concrete Monument Found  
 ○ = 1" Iron Pipe Found  
 --- = Fence Line  
 (0.00) = recorded distance  
 Survey ordered by:  
 Professional Realty, Inc.  
 706 East Geneva Street  
 Delavan, WI 53115

STATE OF WISCONSIN)  
 COUNTY OF WALWORTH) SS  
 I, George T. Dunham, Surveyor, certify that I have surveyed the property described as follows:  
 Lot 5, Block 1 of Sunny Side Subdivision located in the City of Delavan, Walworth County, Wisconsin,  
 and that the plat shown hereon is a correct representation thereof and shows the size and location of the property, its exterior boundaries, the location of all visible structures and dimensions of all principal buildings thereon, boundary fences, apparent easements, roadways and visible encroachments, if any, and that I have surveyed the property hereon described, according to the official records, to the best of my knowledge and belief.  
 October 12, 1994

*George T. Dunham*  
 George T. Dunham, Surveyor

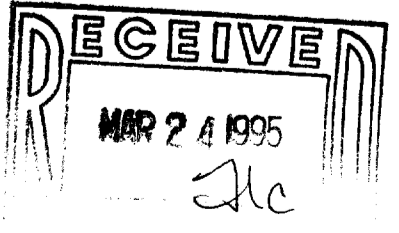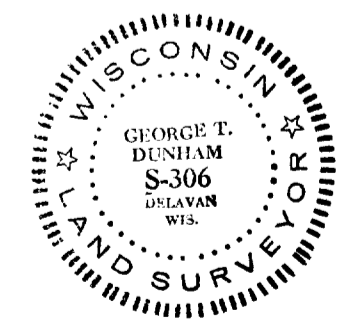

44370  
 YSS-5  
 GMB 1020  
 002-1421