
## ABELL SURVEYING & MAPPING DELAVAN, WISCONSIN 53115 414-728-6737


## WHISPERING PINES DRIVE

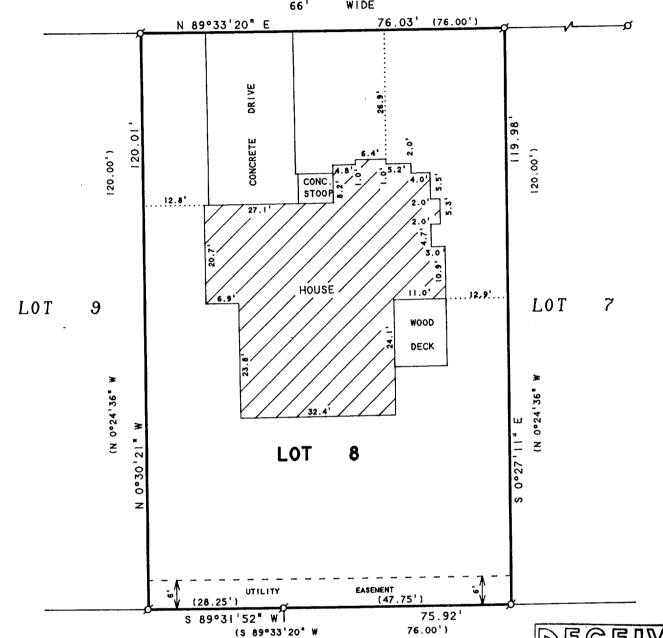

NOTE: BEARINGS ARE REFERENCED TO THE RECORDED SUBDIVISION PLAT.

## PLAT OF SURVEY OF

LOT 8, WHISPERING PINES, LOCAT IN THE CITY OF DELAVAN, WALWOR COUNTY, WISCONSIN.

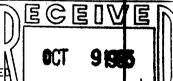



SCALE | " = 20 '

LEGEND

Ø -IRON PIPE FOUND
( )-RECORDED AS

I HEREBY CERTIFY THAT I HAVE SURVEYED THE ABOVE DESCRIBED PROPERTY AND THAT THE ABOVE MAP IS A TRUE REPRESENTATION THEREOF AND SHOWS THE SIZE AND LOCATION OF THE PROPERTY. ITS EXTERIOR BOUNDARIES. THE LOCATION OF ALL VISIBLE STRUCTURES AND DIMENSIONS OF ALL PRINCIPAL BUILDINGS THEREON. BOUNDARY FENCES. APPARENT EASEMENTS. ROADWAYS AND VISIBLE ENCROACHMENTS. IF ANY. TO THE BEST OF MY KNOWLEDGE AND BELIEF:

THIS SURVEY IS MADE FOR THE USE OF THE PRESENT OWNERS OF THE PROPERTY. AND ALSO THOSE WHO PURCHASE. MORTGAGE. OR GUARANTEE THE TITLE THERETO WITHIN ONE (I) YEAR FROM DATE HEREON.

Lail 7. Plell

DAVID F. ABELL WISCONSIN REGISTERED LAND SURVEYOR, 3-1596

ORDERED BY: PREFERRED HOMES, INC.

2903 BORG ROAD DELAVAN, WI 53115 August 11, 1995

JOB NUMBER - 9514

XWP-8