


Rt. 3, Box 273  
Elkhorn, Wisconsin 53121  
Phone: (414) 723-4260 (office)  
(414) 723-7209 (FAX)

LOT 6 OF BLOCK 3 OF CHESTNUT RIDGE  
SUBDIVISION WEST LOCATED IN THE SOUTHEAST  
1/4 OF THE SOUTHWEST 1/4 AND THE  
NORTHEAST 1/4 OF THE SOUTHWEST 1/4 OF  
SECTION 13, TOWN 2 NORTH, RANGE 15 EAST,  
CITY OF DELAVAN, WALWORTH COUNTY,  
WISCONSIN.

JOB REFERENCE NO. 112-02-006  
P.O. # 7391 DATED 2/7/96

WOOD STAKES OR 60 PENNY SPIKES HAVE BEEN PLACED AT BUILDING CORNERS. BUILDER IS TO VERIFY DIMENSIONS WHICH HAVE BEEN ROUNDED TO THE NEAREST TENTH OF A FOOT TO INSURE PROPER PLAN INTERPRETATION AND CONTACT THIS OFFICE IMMEDIATELY IF ANY DISCREPANCY EXISTS.

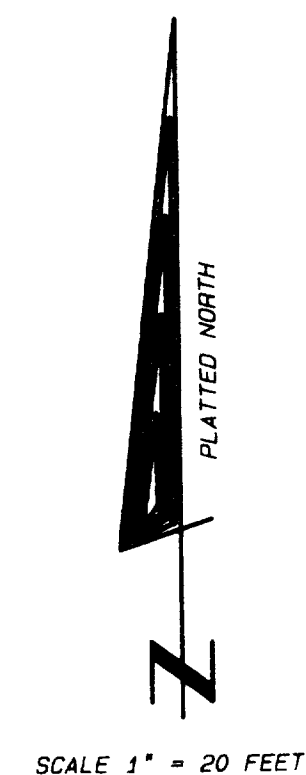

- FOUND IRON PIPE
- FOUND IRON ROD
- FOUND BRASS CAPPED MONUMENT
- \* FOUND CONCRETE MONUMENT
- + CHISEL CUT IN CONCRETE
- SET IRON ROD, 24" LONG, WEIGHING 1.5 LBS. LINEAL FT., 3/4" DIA
- SET IRON ROD, 30" LONG, WEIGHING 4.5 LBS. LINEAL FT., 1 1/16" DIA

(xx) RECORDED AS DIMENSION

— — — — — EXISTING FENCE

I hereby certify that the above described property has been surveyed by me or under my direction and that the above map is a true and correct representation and shows the site and location of the property, its principal boundaries, the location of all visible structures and dimensions of all principal buildings thereon, boundary fences, apparent easements, roadways and visible encroachments.

This survey was made for the purpose of the present owners of the property, and also those who purchase, mortgage or guarantee the title thereto within one year from date hereof.

Date: 2-20-96 Job No. 96.205

XQ RW-15

002-1494