

DUNHAM & RASMUSSEN SURVEYING & ENGINEERING DELAVAN, WISCONSIN

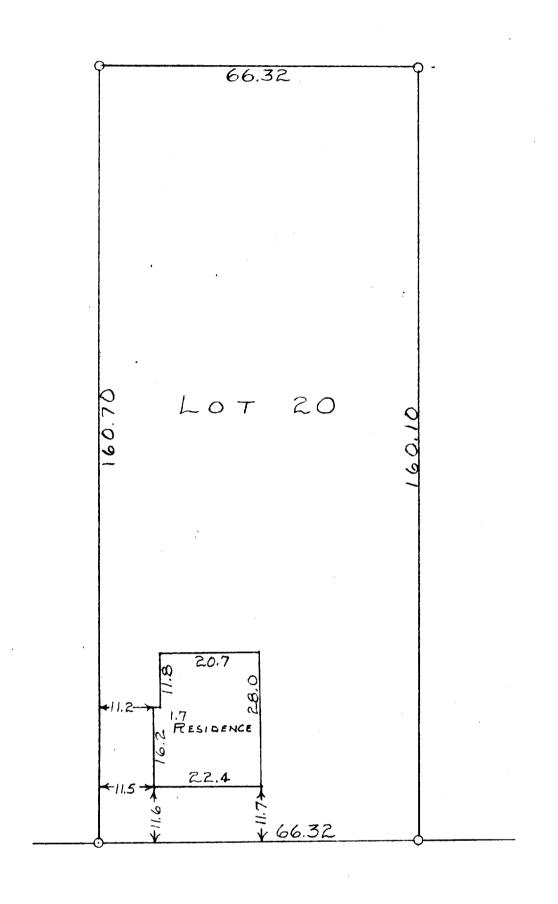

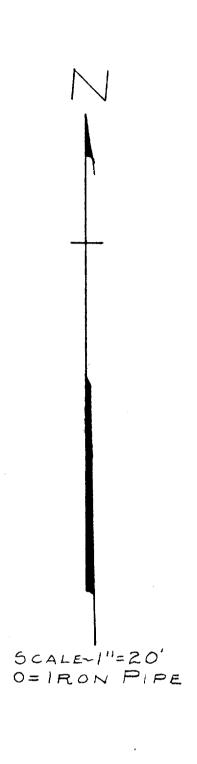

GENEVA

STREET

STATE **OF** WISCONSIN) SS WALWORTH COUNTY)

I, George T. Dunham, do hereby certify that I have surveyed the property described as follows,

Lot 20, Block 4 of Passage, Aram and Downie Addition to the City of Delavan,

Walworth County, Wisconsin.

and that the plat shown above is a correct representation of the property lines and of the improvements located thereon.

May 13, 1960

George T. Dunham, Surveyor

K & E-198L 250-4-60