FARRIS, HANSEN & ASSOCIATES, INC.

ENGINEERING, ARCHITECTURE, SURVEYING
7 RIDGWAY COURT - P.O.BOX 437, ELKHORN, WISCONSIN 53121
PHONE: (414) 723-2098 FAX: (414) 723-5886

PLAT OF SURVEY


LOT 1 BLOCK 2

CHESTNIT RIDGE SUBDIVISION WEST

LOCATED IN EAST 1/2 OF THE SW 1/4 OF SEC. 13


TOWN 2 NORTH, RANGE 15 EAST, CITY OF DELAVAN

WALWORTH COUNTY, WISCONSIN

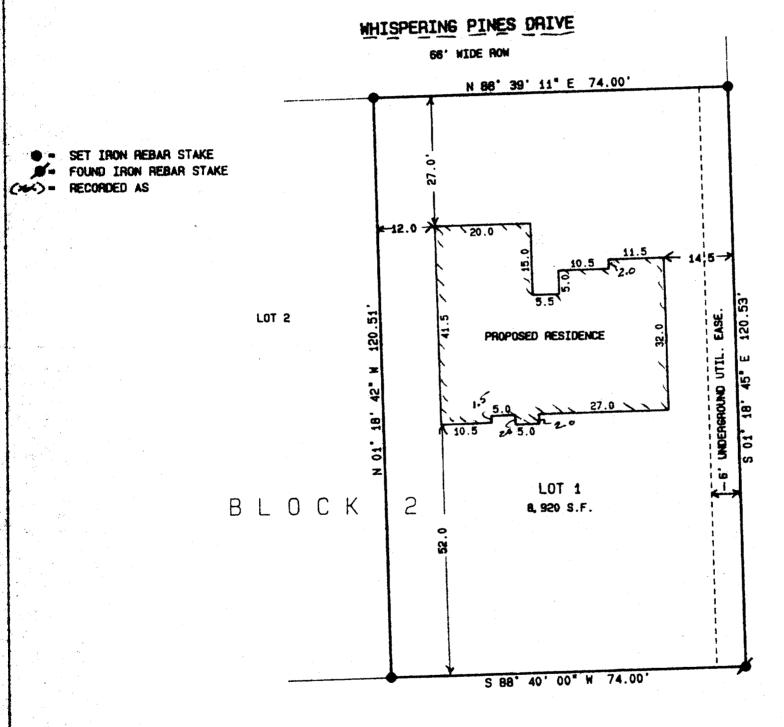

WIS. COORD. SYSTEM SOUTH ZONE

WORK ORDERED BY: BROOKSTONE HOMES 4450 MILTON AVE., SUITE 206 JANESVILLE, WISCONSIN 53546

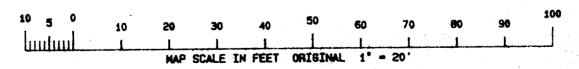

NOTE: COPIES OF THIS MAP TO WHICH THE FOLLOWING CERTIFICATE WILL APPLY ARE BLUE LINE PRINTS SHOWING SURVEYOR'S ORIGINAL SEAL AND SIGNATURE IN BLACK INK. COPIES BY ANY OTHER HEARS MAY HAVE ALTERATIONS WHICH DO NOT REPRESENT THE SURVEYOR'S WORK PRODUCT.


I HEREBY CERTIFY THAT THE ABOVE DESCRIBED PROPERTY HAS SEEN SURVEYED UNDER MY DIRECTION AND THAT THE ABOVE MAP IS A TRUE REPRESENTATION THEREOF AND SHOWS THE SIZE AND LOCATION OF THE PROPERTY AND ITS EXTERIOR BOUNDARIES. THIS SURVEY IS MADE FOR THE USE OF THE PROPERTY AND ALSO THOSE WIG PURCHASE, HORTEAGE, OR SUMMANTEE THE TITLE THERETO WITHIN ONE YEAR FROM THE DATE HEREOF.

DATED: 7-17-96

filler fleren

ETER 8, BONDON A.L.S. 2101



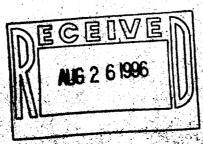

PROJ 3690.01.2

XT5m-8

1002-1550