


**ABELL  
SURVEYING & MAPPING**  
DELAVAN, WISCONSIN 53115  
414-728-6737



N

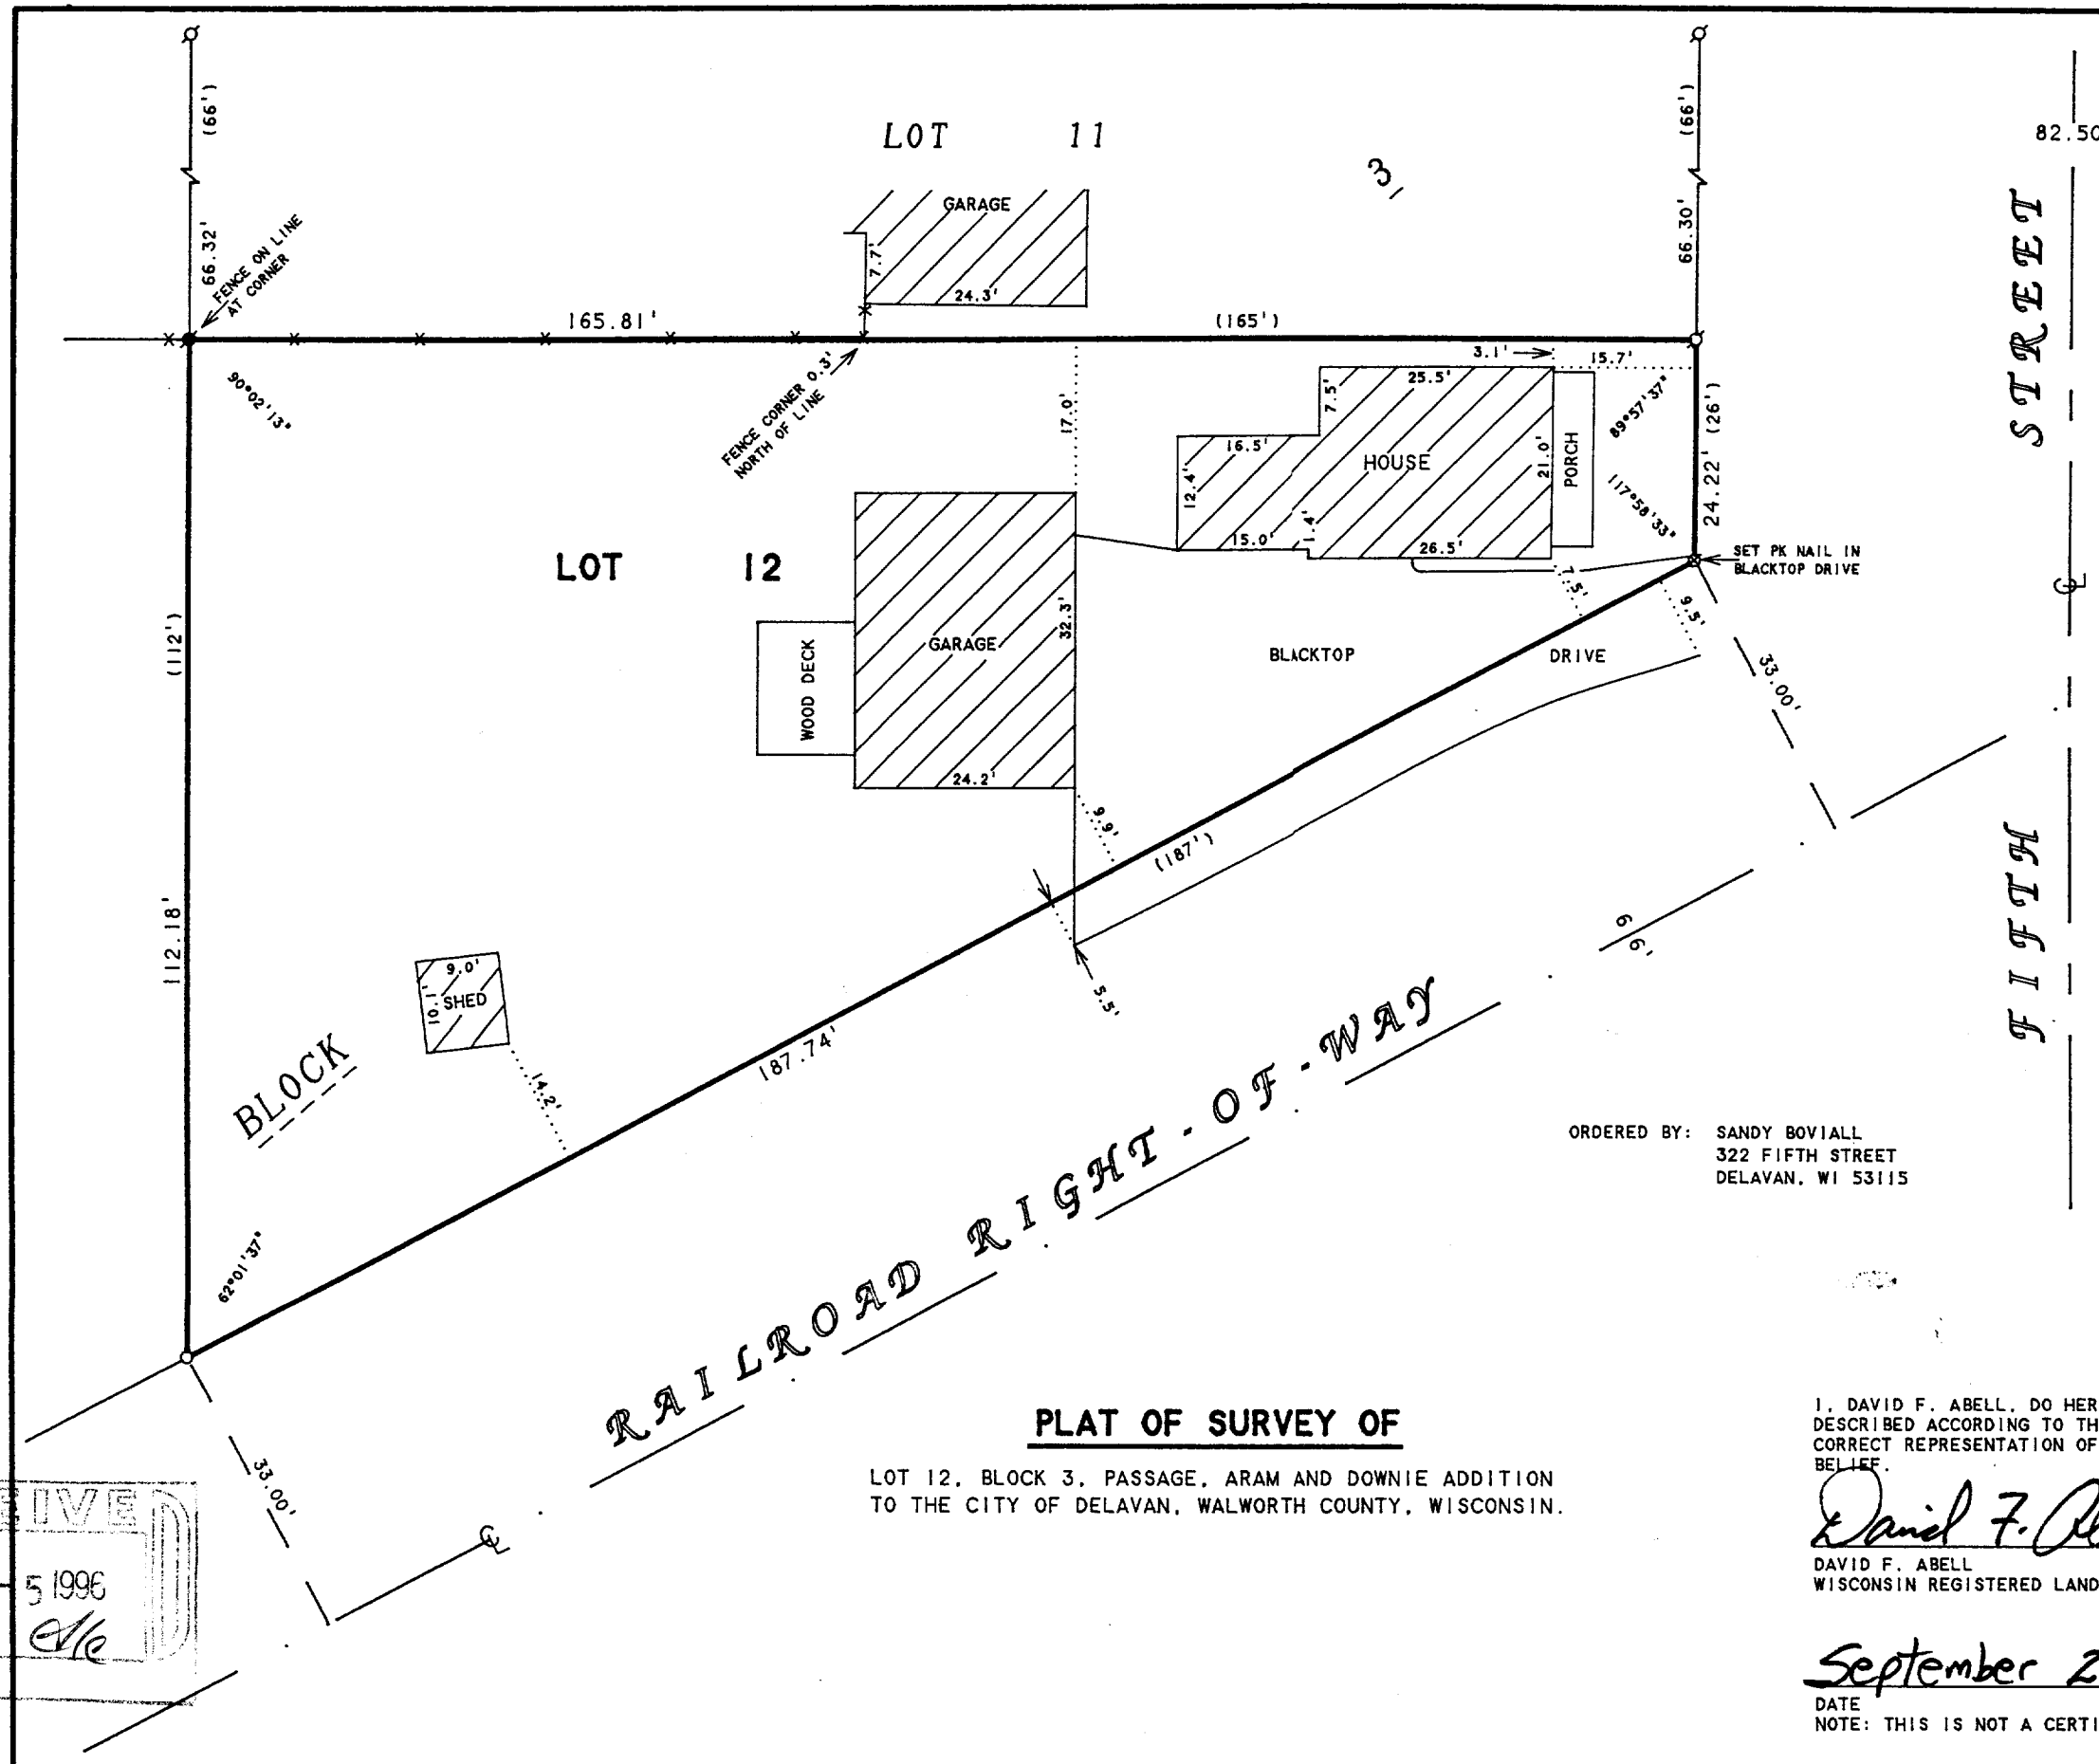

SCALE 1"=20'

LEGEND

- - IRON PIPE FOUND
- - IRON ROD FOUND
- - IRON PIPE SET
- ⊙ - PK NAIL SET
- \* - WIRE FENCE
- ( ) - RECORDED AS

ORDERED BY: SANDY BOVIALL  
322 FIFTH STREET  
DELAVAN, WI 53115

Date of field work - 7/31/96

**PLAT OF SURVEY OF**

LOT 12, BLOCK 3, PASSAGE, ARAM AND DOWNIE ADDITION  
TO THE CITY OF DELAVAN, WALWORTH COUNTY, WISCONSIN.


I, DAVID F. ABELL, DO HEREBY CERTIFY THAT I HAVE SURVEYED THE PROPERTY HEREON DESCRIBED ACCORDING TO THE OFFICAL RECORDS AND THAT THE PLAT HEREON IS A CORRECT REPRESENTATION OF THE PROPERTY LINES TO THE BEST OF MY KNOWLEDGE AND BELIEF.

*David F. Abell*

DAVID F. ABELL  
WISCONSIN REGISTERED LAND SURVEYOR, S-1596

*September 26, 1996*

DATE: \_\_\_\_\_ JOB NUMBER - 96125  
NOTE: THIS IS NOT A CERTIFIED COPY UNLESS SEALED.

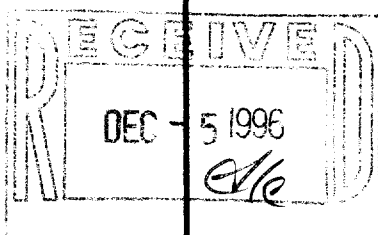

XP-39  
002-1557