

ABELL  
SURVEYING & MAPPING  
DELAVER, WISCONSIN 53115  
414-728-6737

CENTER STREET


N



SCALE 1"=20'

LEGEND

- Ø - IRON PIPE FOUND
- SW - SIDEWALK
- CS - CONCRETE STOOP
- △ - UTILITY POLE
- - UTILITY PED.
- \* - CHAIN LINK FENCE
- ( ) - RECORDED AS

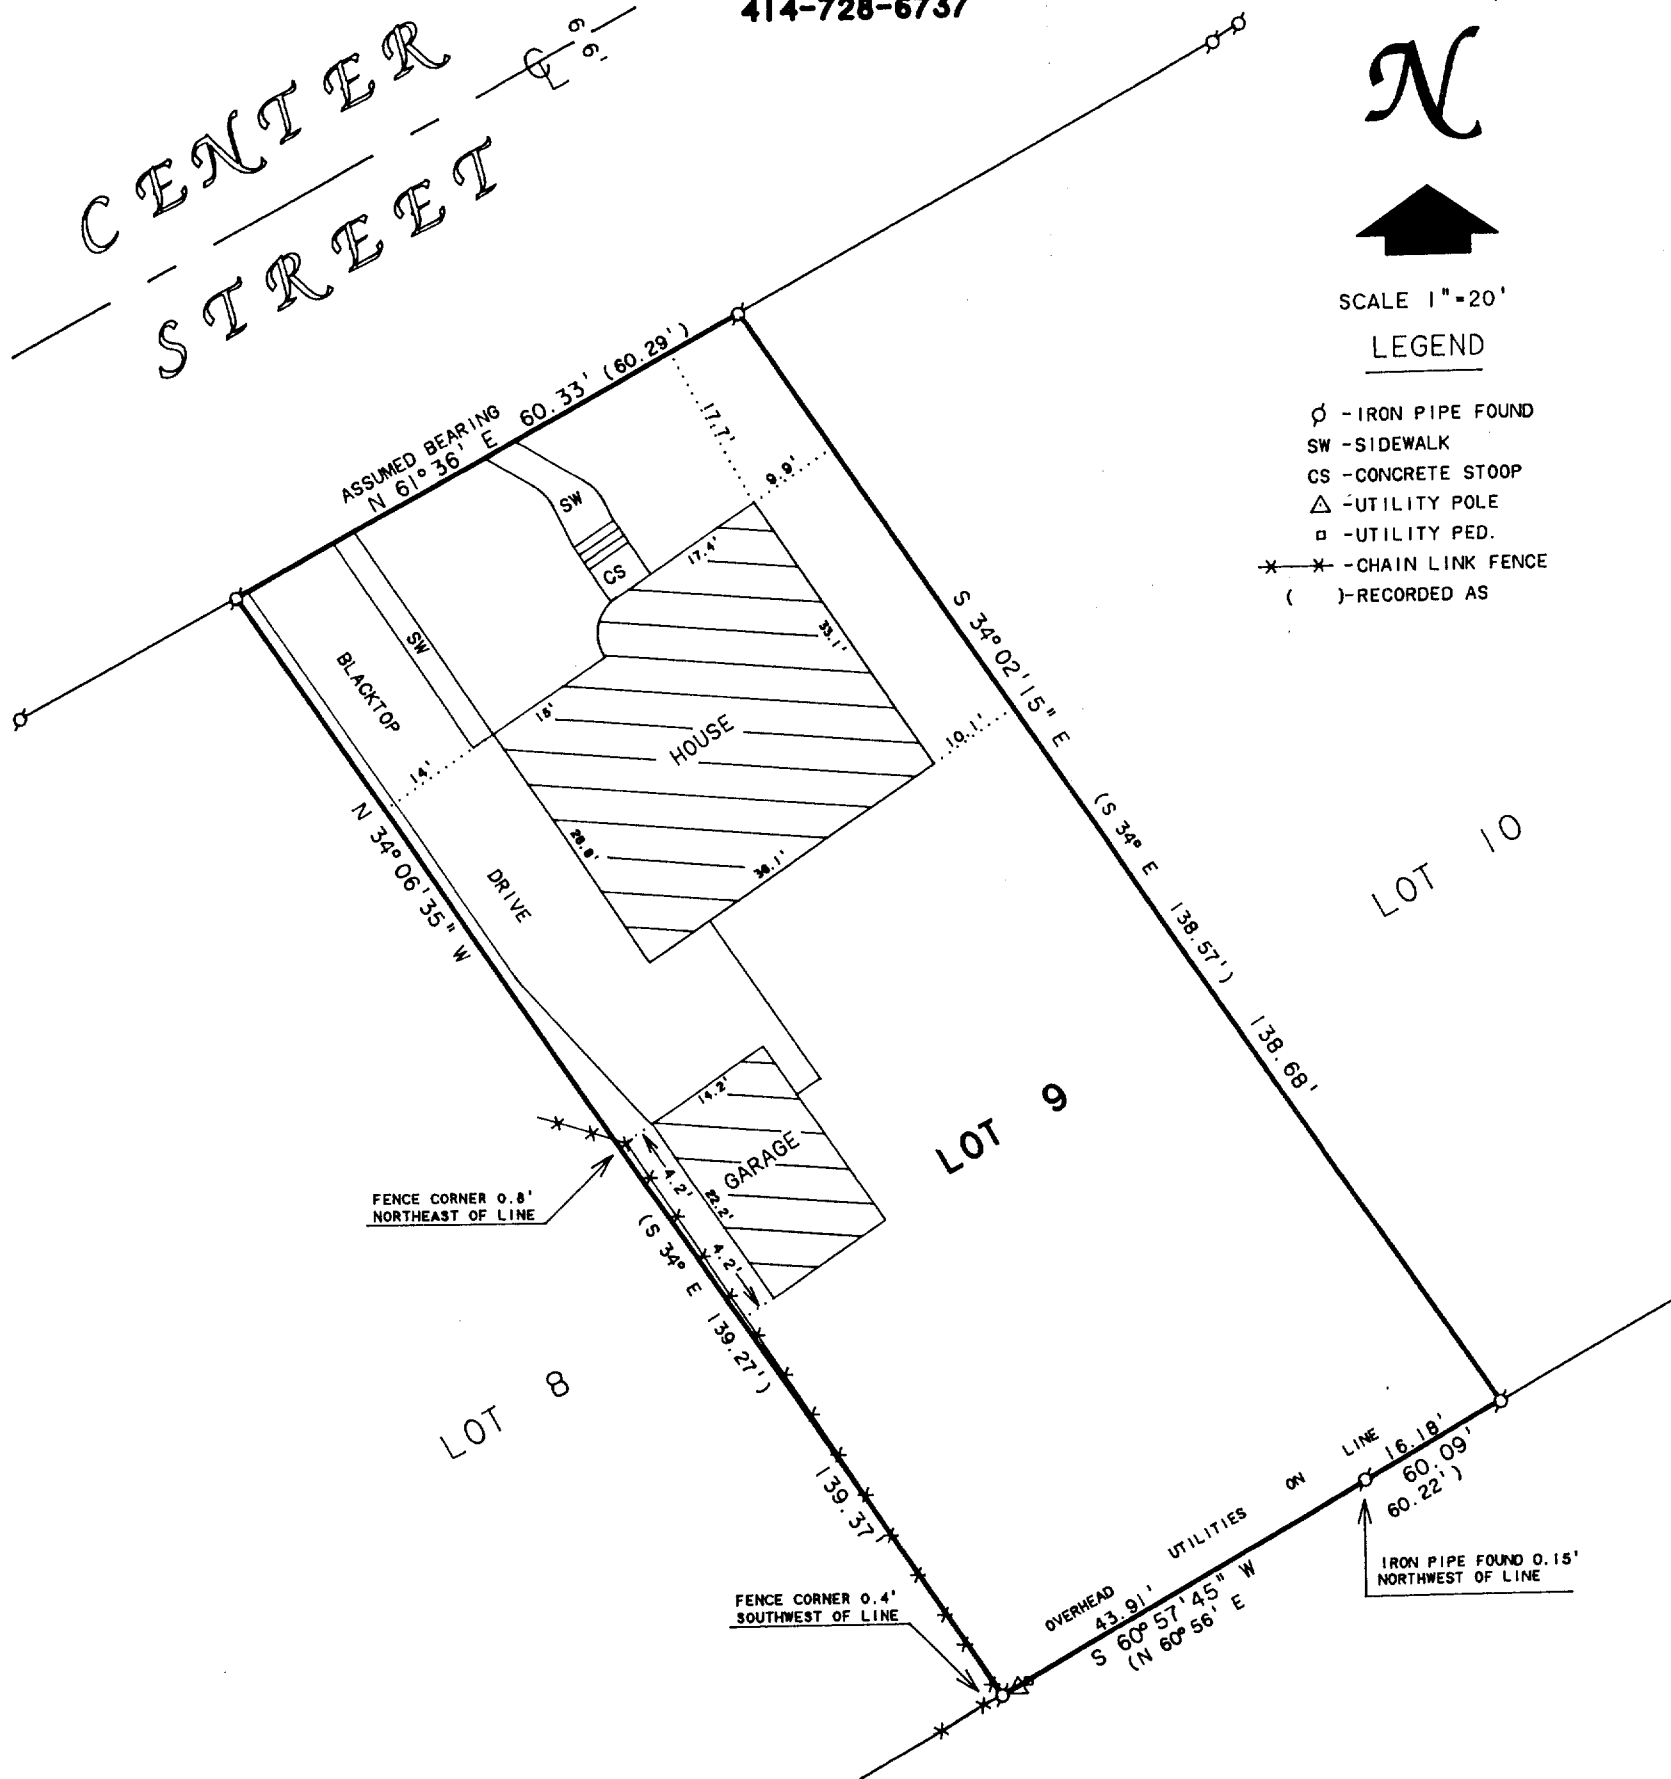

PLAT OF SURVEY OF

LOT 9, CENTER COURT SUBDIVISION, CITY OF DELAVER  
WALWORTH COUNTY, WISCONSIN.

REVISED DATE: NOVEMBER 4, 1996  
ORDERED BY: LYNN SWETS  
932 CENTER STREET  
DELAVER, WI 53115

I HEREBY CERTIFY THAT I HAVE SURVEYED THE ABOVE DESCRIBED PROPERTY AND THAT THE ABOVE MAP IS A TRUE REPRESENTATION THEREOF AND SHOWS THE SIZE AND LOCATION OF THE PROPERTY, ITS EXTERIOR BOUNDARIES, THE LOCATION OF ALL VISIBLE STRUCTURES AND DIMENSIONS OF ALL PRINCIPAL BUILDINGS THEREON, BOUNDARY FENCES, APPARENT EASEMENTS, ROADWAYS AND VISIBLE ENCROACHMENTS, IF ANY, TO THE BEST OF MY KNOWLEDGE AND BELIEF.


THIS SURVEY IS MADE FOR THE USE OF THE PRESENT OWNERS OF THE PROPERTY, AND ALSO THOSE WHO PURCHASE, MORTGAGE, OR GUARANTEE THE TITLE THERETO WITHIN ONE (1) YEAR FROM DATE HEREON.

*David F. Abell*  
DAVID F. ABELL  
WISCONSIN REGISTERED LAND SURVEYOR, S-1596

March 27, 1991

DATE  
NOTE: THIS IS NOT A CERTIFIED COPY UNLESS SEALED.

JOB NUMBER 91044

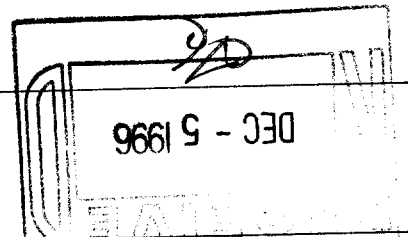

XC-9

002-1558