


SOUTHEAST CORNER OF LOT 11, L. E. DOWNIE'S ADDITION

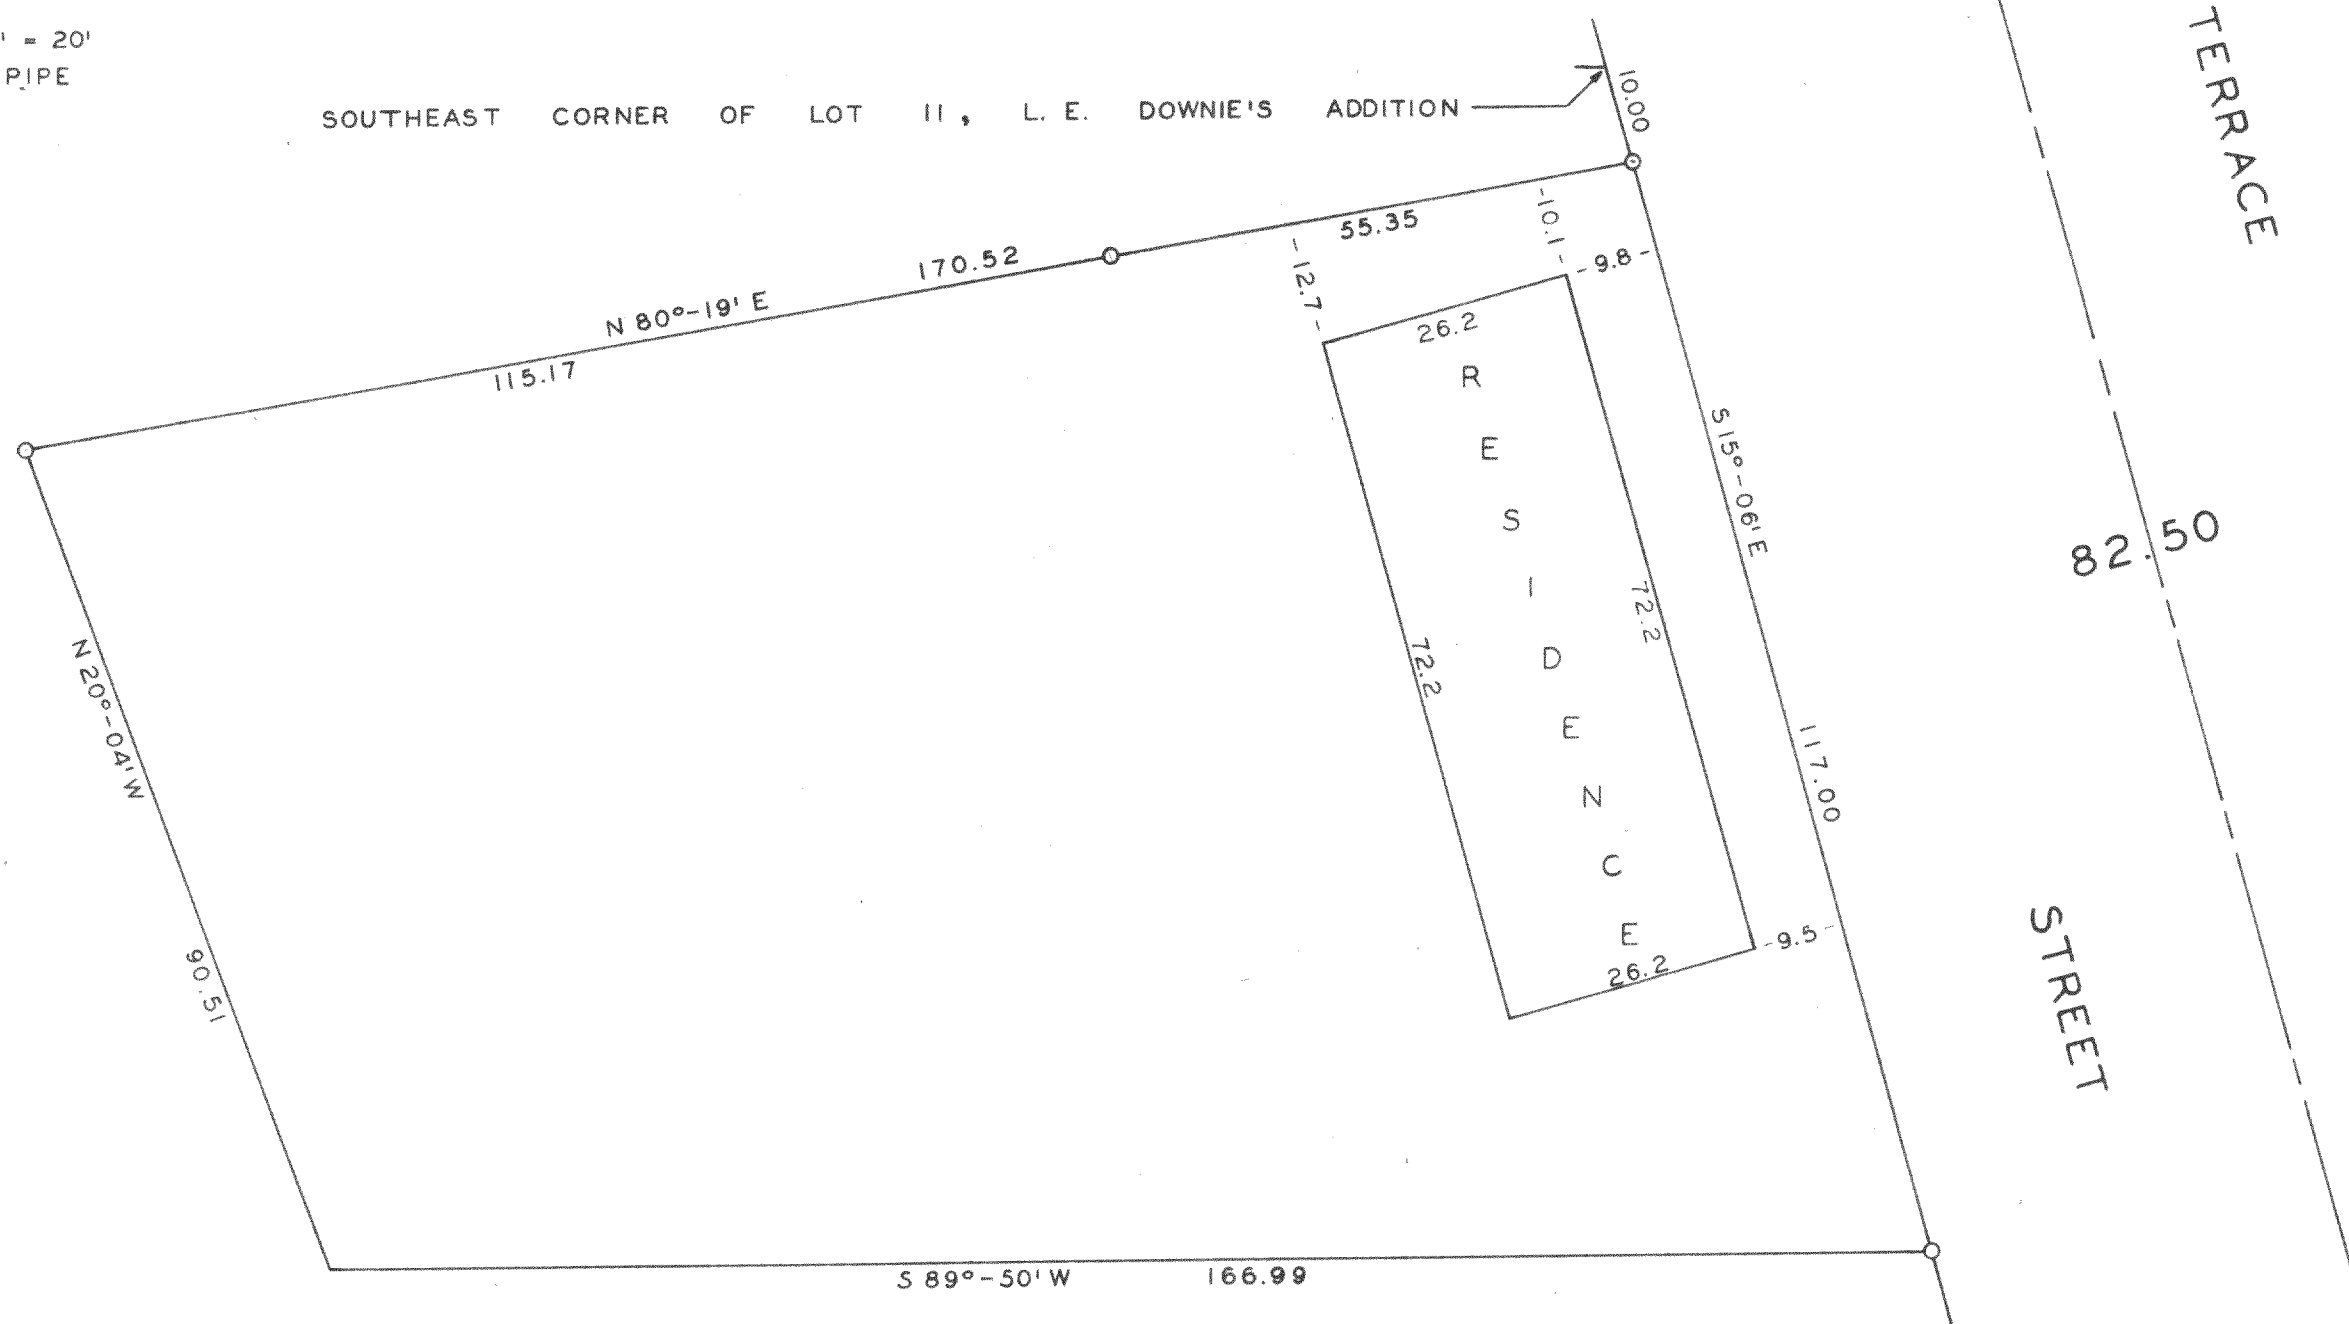

George F. Dunham
George F. Dunham, Surveyor