

LOT 29
BLOCK 4

ARBOR RIDGE DRIVE

66' WIDE ROW

BENCH MARK
TOP OF IRON REBAR
EL = 903.11

10 5 0 10 20 30 40 50 60 70 80 90 100
MAP SCALE IN FEET ORIGINAL 1" = 20'

PLAT OF SURVEY

LOT 20 OF BLOCK 5 OF LAKE MEADOWS
ADDITION NO. 1, LOCATED IN THE NE,
SW & SE 1/4'S OF THE SE 1/4 OF
SECTION 7, TOWN 2 NORTH, RANGE 16
EAST, CITY OF DELAVAN, WALWORTH
COUNTY, WISCONSIN


PLAT OF SURVEY
LOT 20 BLOCK 5
LAKE MEADOWS ADDITION NO. 1

WORK ORDERED BY: PREFERRED HOMES
WILLIAM & JANE BOHN
2903 BORG ROAD
DELAVAN, WISCONSIN 53115

FARRIS, HANSEN & ASSOCIATES, INC.
Engineering, Architecture, Surveying
7 Ridgeway Court P.O. Box 437
ELKHORN, WISCONSIN 53121
Office: (414) 723-2098
Fax: (414) 723-5886

REVISIONS

PROJECT NO.
3686.20
DATE
10/20/95
SHEET NO.
1 OF 1

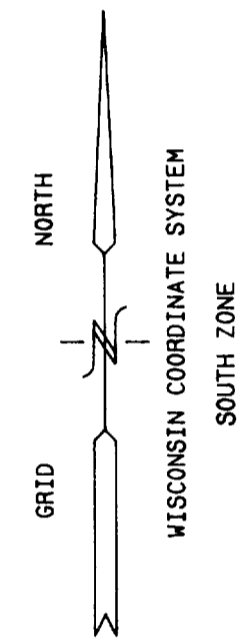


LEGEND

- = SET IRON REBAR STAKE 3/4" DIA.
- = FOUND IRON PIPE STAKE 1" DIA.
- = FOUND IRON REBAR STAKE 3/4" DIA.
- = FOUND CONCRETE COUNTY MONUMENT
- = RECORDED AS


NOTE: COPIES OF THIS MAP TO WHICH THE FOLLOWING
CERTIFICATE WILL APPLY ARE BLUE LINE PRINTS SHOWING
SURVEYOR'S ORIGINAL SEAL AND SIGNATURE IN BLACK INK.
COPIES BY ANY OTHER MEANS MAY HAVE ALTERATIONS WHICH DO
NOT REPRESENT THE SURVEYOR'S WORK PRODUCT.

I HEREBY CERTIFY THAT THE ABOVE DESCRIBED PROPERTY HAS
BEEN SURVEYED UNDER MY DIRECTION AND THAT THE ABOVE MAP IS
A TRUE REPRESENTATION THEREOF AND SHOWS THE SIZE AND
LOCATION OF THE PROPERTY AND ITS EXTERIOR BOUNDARIES.
THIS SURVEY IS MADE FOR THE USE OF THE PRESENT OWNERS OF
THE PROPERTY, AND ALSO THOSE WHO PURCHASE, MORTGAGE, OR
GUARANTEE THE TITLE THERETO WITHIN ONE YEAR FROM THE DATE
HEREOF.

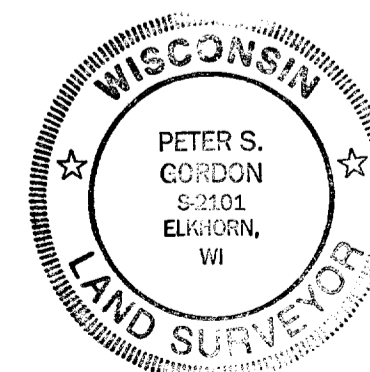

DATED: 10/23/95
REV. 1-23-97
TO SHOW SIZE & LOC. OF PROP. L.R.S.

Peter S. Gordon
PETER S. GORDON R.L.S. 2101

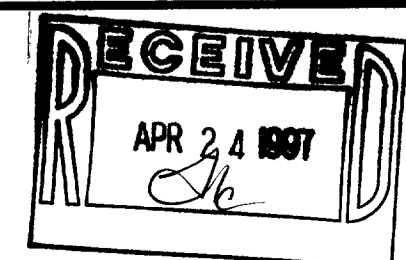


LOT 29
BLOCK 4

ARBOR RIDGE DRIVE


66' WIDE ROW

BENCHMARK
TOP OF IRON REBAR
EL = 903.11

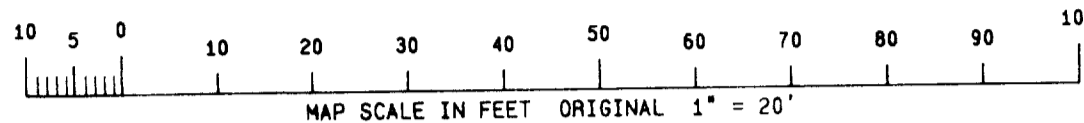


PLAT OF SURVEY

LOT 20 OF BLOCK 5 OF LAKE MEADOWS
ADDITION NO. 1, LOCATED IN THE NE,
SW & SE 1/4'S OF THE SE 1/4 OF
SECTION 7, TOWN 2 NORTH, RANGE 16
EAST, CITY OF DELAVAN, WALWORTH
COUNTY, WISCONSIN

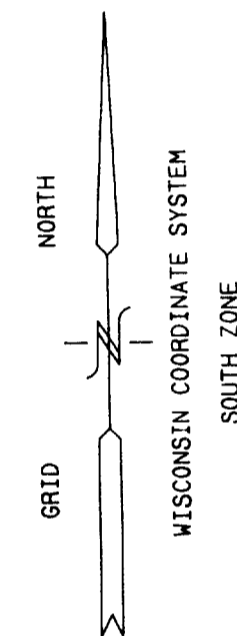

LEGEND

- = SET IRON REBAR STAKE 3/4" DIA.
- = FOUND IRON PIPE STAKE 1" DIA.
- = FOUND IRON REBAR STAKE 3/4" DIA.
- = FOUND CONCRETE COUNTY MONUMENT
- = RECORDED AS

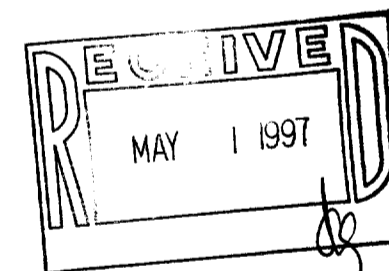

NOTE: COPIES OF THIS MAP TO WHICH THE FOLLOWING
CERTIFICATE WILL APPLY ARE BLUE LINE PRINTS SHOWING
SURVEYOR'S ORIGINAL SEAL AND SIGNATURE IN BLACK INK.
COPIES BY ANY OTHER MEANS MAY HAVE ALTERATIONS WHICH DO
NOT REPRESENT THE SURVEYOR'S WORK PRODUCT.

I HEREBY CERTIFY THAT THE ABOVE DESCRIBED PROPERTY HAS
BEEN SURVEYED UNDER MY DIRECTION AND THAT THE ABOVE MAP IS
A TRUE REPRESENTATION THEREOF AND SHOWS THE SIZE AND
LOCATION OF THE PROPERTY AND ITS EXTERIOR BOUNDARIES.
THIS SURVEY IS MADE FOR THE USE OF THE PRESENT OWNERS OF
THE PROPERTY, AND ALSO THOSE WHO PURCHASE, MORTGAGE, OR
GUARANTEE THE TITLE THERETO WITHIN ONE YEAR FROM THE DATE
HEREOF.



DATED: 10/23/95
REV. 1-23-97
To show 'As Built' RES.

PETER S. GORDON R.L.S. 2101
3-31-77 REV. TO SHOW AS BUILT RES.

PLAT OF SURVEY
LOT 20 BLOCK 5
LAKE MEADOWS ADDITION NO. 1

WORK ORDERED BY: PREFERRED HOMES
WILLIAM & JANE BOHN
2903 BORG ROAD
DELAVAN, WISCONSIN 53115

FARRIS, HANSEN & ASSOCIATES, INC.
Engineering, Architecture, Surveying
7 Ridgway Court P.O. Box 437
ELKHORN, WISCONSIN 53121
Office: (414) 723-2098
Fax: (414) 723-5886

REVISIONS

PROJECT NO.
3686.20
DATE
10/20/95
SHEET NO.
1 OF 1

LOT 18

LOT 19

LOT 20
20,010 S.F.

BLOCK 5

XLM1-8
002-1600