



DUNHAM & RASMUSSEN  
SURVEYING & ENGINEERING  
DELAVAN, WISCONSIN

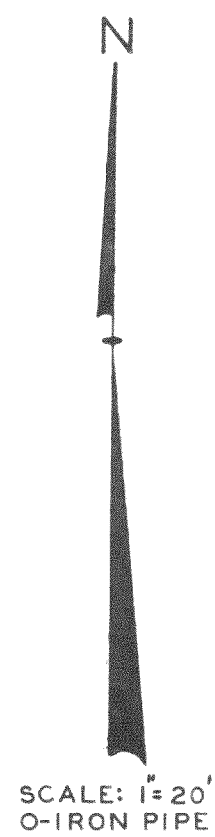

BRADLEY

AVENUE

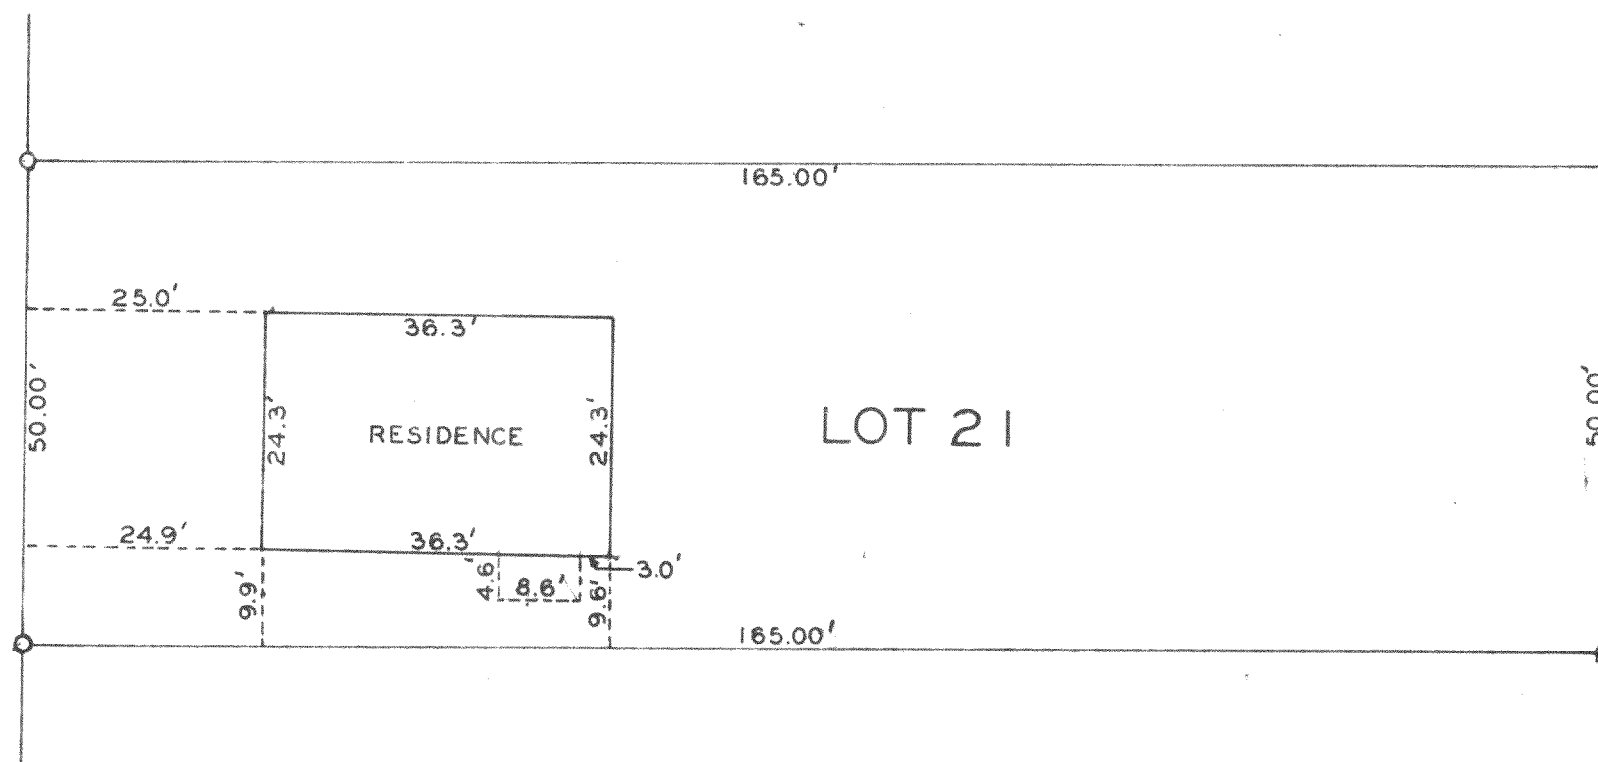

STATE OF WISCONSIN)  
WALWORTH COUNTY ) SS

I, George T. Dunham, do hereby certify that I have surveyed the property described as follows:

Lot 21 of Tyrrell's Subdivision, located in the City of Delavan, Walworth County, Wisconsin.  
and that the plat shown above is a correct representation of the property lines and the improvements located thereon.  
June 1, 1961

George T. Dunham  
George T. Dunham, Wisconsin Land Surveyor No. S-306