



LOT SURVEY W/ IMPROVEMENTS

WORK ORDERED BY:
BROOKSTONE HOMES
4450 MILTON AVE. SUITE 206
JANESVILLE, WI 53546



FARRIS, HANSEN & ASSOCIATES, INC.
Engineering, Architecture, Surveying
7 Ridgway Court P.O. Box 437
ELKHORN, WISCONSIN 53121
Office: (414) 723-2098
Fax: (414) 723-5886

REVISIONS

PROJECT NO.
3690.3.B3
DATE:
7/28/97
SHEET NO.
1 OF 1

PLAT OF SURVEY

LOT 3, BLOCK 3, CHESTNUT RIDGE SUBDIVISION WEST
LOCATED IN THE SE 1/4 OF THE SW 1/4 & NE 1/4 OF THE SW 1/4
SECTION 13, TOWN 2 NORTH, RANGE 15 EAST,
CITY OF DELAVAN, WALWORTH COUNTY, WISCONSIN

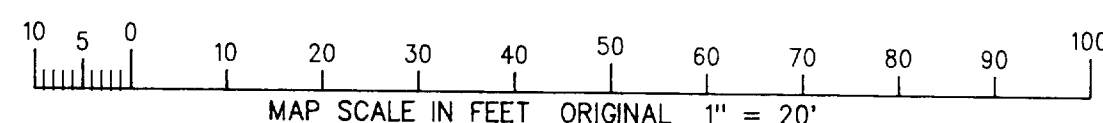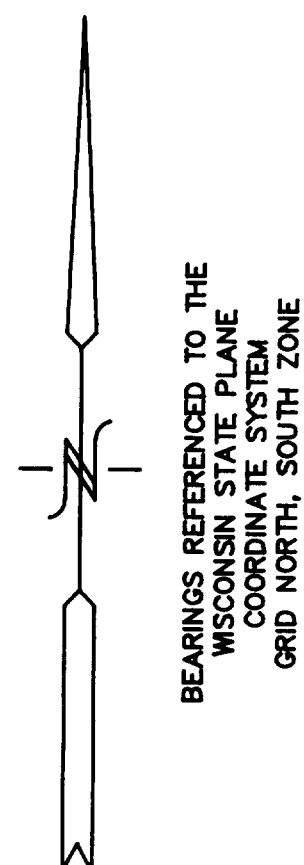

LEGEND
● FOUND IRON REBAR
() RECORDED AS

ASPEN COURT
(66' WIDE)

LOT 4

LOT 3
22,350 S.F.

LOT 2

CHESTNUT RIDGE
ADDITION 1

NOTE: COPIES OF THIS MAP TO WHICH THE FOLLOWING CERTIFICATE
WILL APPLY ARE BLUE LINE PRINTS SHOWING SURVEYOR'S ORIGINAL
SEAL AND SIGNATURE IN BLACK INK. COPIES BY ANY OTHER MEANS
MAY HAVE ALTERATIONS WHICH DO NOT REPRESENT THE SURVEYOR'S
WORK PRODUCT.

I HEREBY CERTIFY THAT THE ABOVE DESCRIBED PROPERTY HAS BEEN
SURVEYED UNDER MY DIRECTION AND THAT THE ABOVE MAP IS A TRUE
REPRESENTATION THEREOF AND SHOWS THE SIZE AND LOCATION OF
THE PROPERTY AND ITS EXTERIOR BOUNDARIES. THIS SURVEY IS
MADE FOR THE USE OF THE PRESENT OWNERS OF THE PROPERTY, AND
ALSO THOSE WHO PURCHASE, MORTGAGE, OR GUARANTEE THE TITLE
THERE TO WITHIN ONE YEAR FROM THE DATE HEREOF.

DATED: 7/28/97

PETER S. GORDON
PETER S. GORDON R.L.S. 2101

