
ABELL SURVEYING & MAPPING

1140 SEQUOIA STREET . DELAVAN, WISCONSIN 53115 414-728-6737

STREET

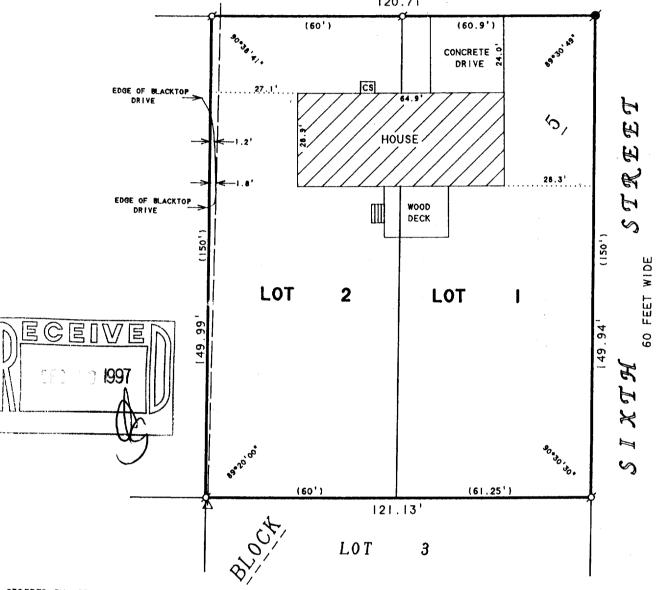

PLAT OF SURVEY OF

LOTS I AND 2. BLOCK 5. FAIRVIEW HEIGHTS. LOCATED IN THE CITY OF DELAVAN, WALWORTH COUNTY, WISCONSIN.

I HEREBY CERTIFY THAT I HAVE SURVEYED THE ABOVE DESCRIBED PROPERTY AND THAT THE ABOVE MAP IS A TRUE REPRESENTATION THEREOF AND SHOWS THE SIZE AND LOCATION OF THE PROPERTY, ITS EXTERIOR BOUNDARIES, THE LOCATION OF ALL VISIBLE STRUCTURES AND DIMENSIONS OF ALL PRINCIPAL BUILDINGS THEREON, BOUNDARY FENCES, APPARENT EASEMENTS, ROADWAYS AND VISIBLE ENCROACHMENTS, IF ANY, TO THE BEST OF MY KNOWLEDGE AND BELIEF.

THIS SURVEY IS MADE FOR THE USE OF THE PRESENT OWNERS OF THE PROPERTY, AND ALSO THOSE WHO PURCHASE, MORTGAGE, OR GUARANTEE THE TITLE THERETO WITHIN ONE (I) YEAR FROM DATE HEREON.

October 13, 1997

DATE HOTE: THIS IS NOT A CERTIFIED COPY UNLESS SEALED.

PHOENIX 66 FEET WIDE 120.71

ORDERED BY: PROFESSIONAL REALTY 1155 E. GENEVA STREET DELAVAN, WI 53115



SCALE | "-30" LEGEND

Ø -IRON PIPE FOUND ■ -IRON BAR FOUND

)-RECORDED AS

A -UTILITY POLE -OVERHAED UTILITY LINE CS -CONCRETE STOOP