


ABELL SURVEYING & MAPPING

1140 SEQUOIA STREET • DELAVAN, WISCONSIN 53115
414-728-6737

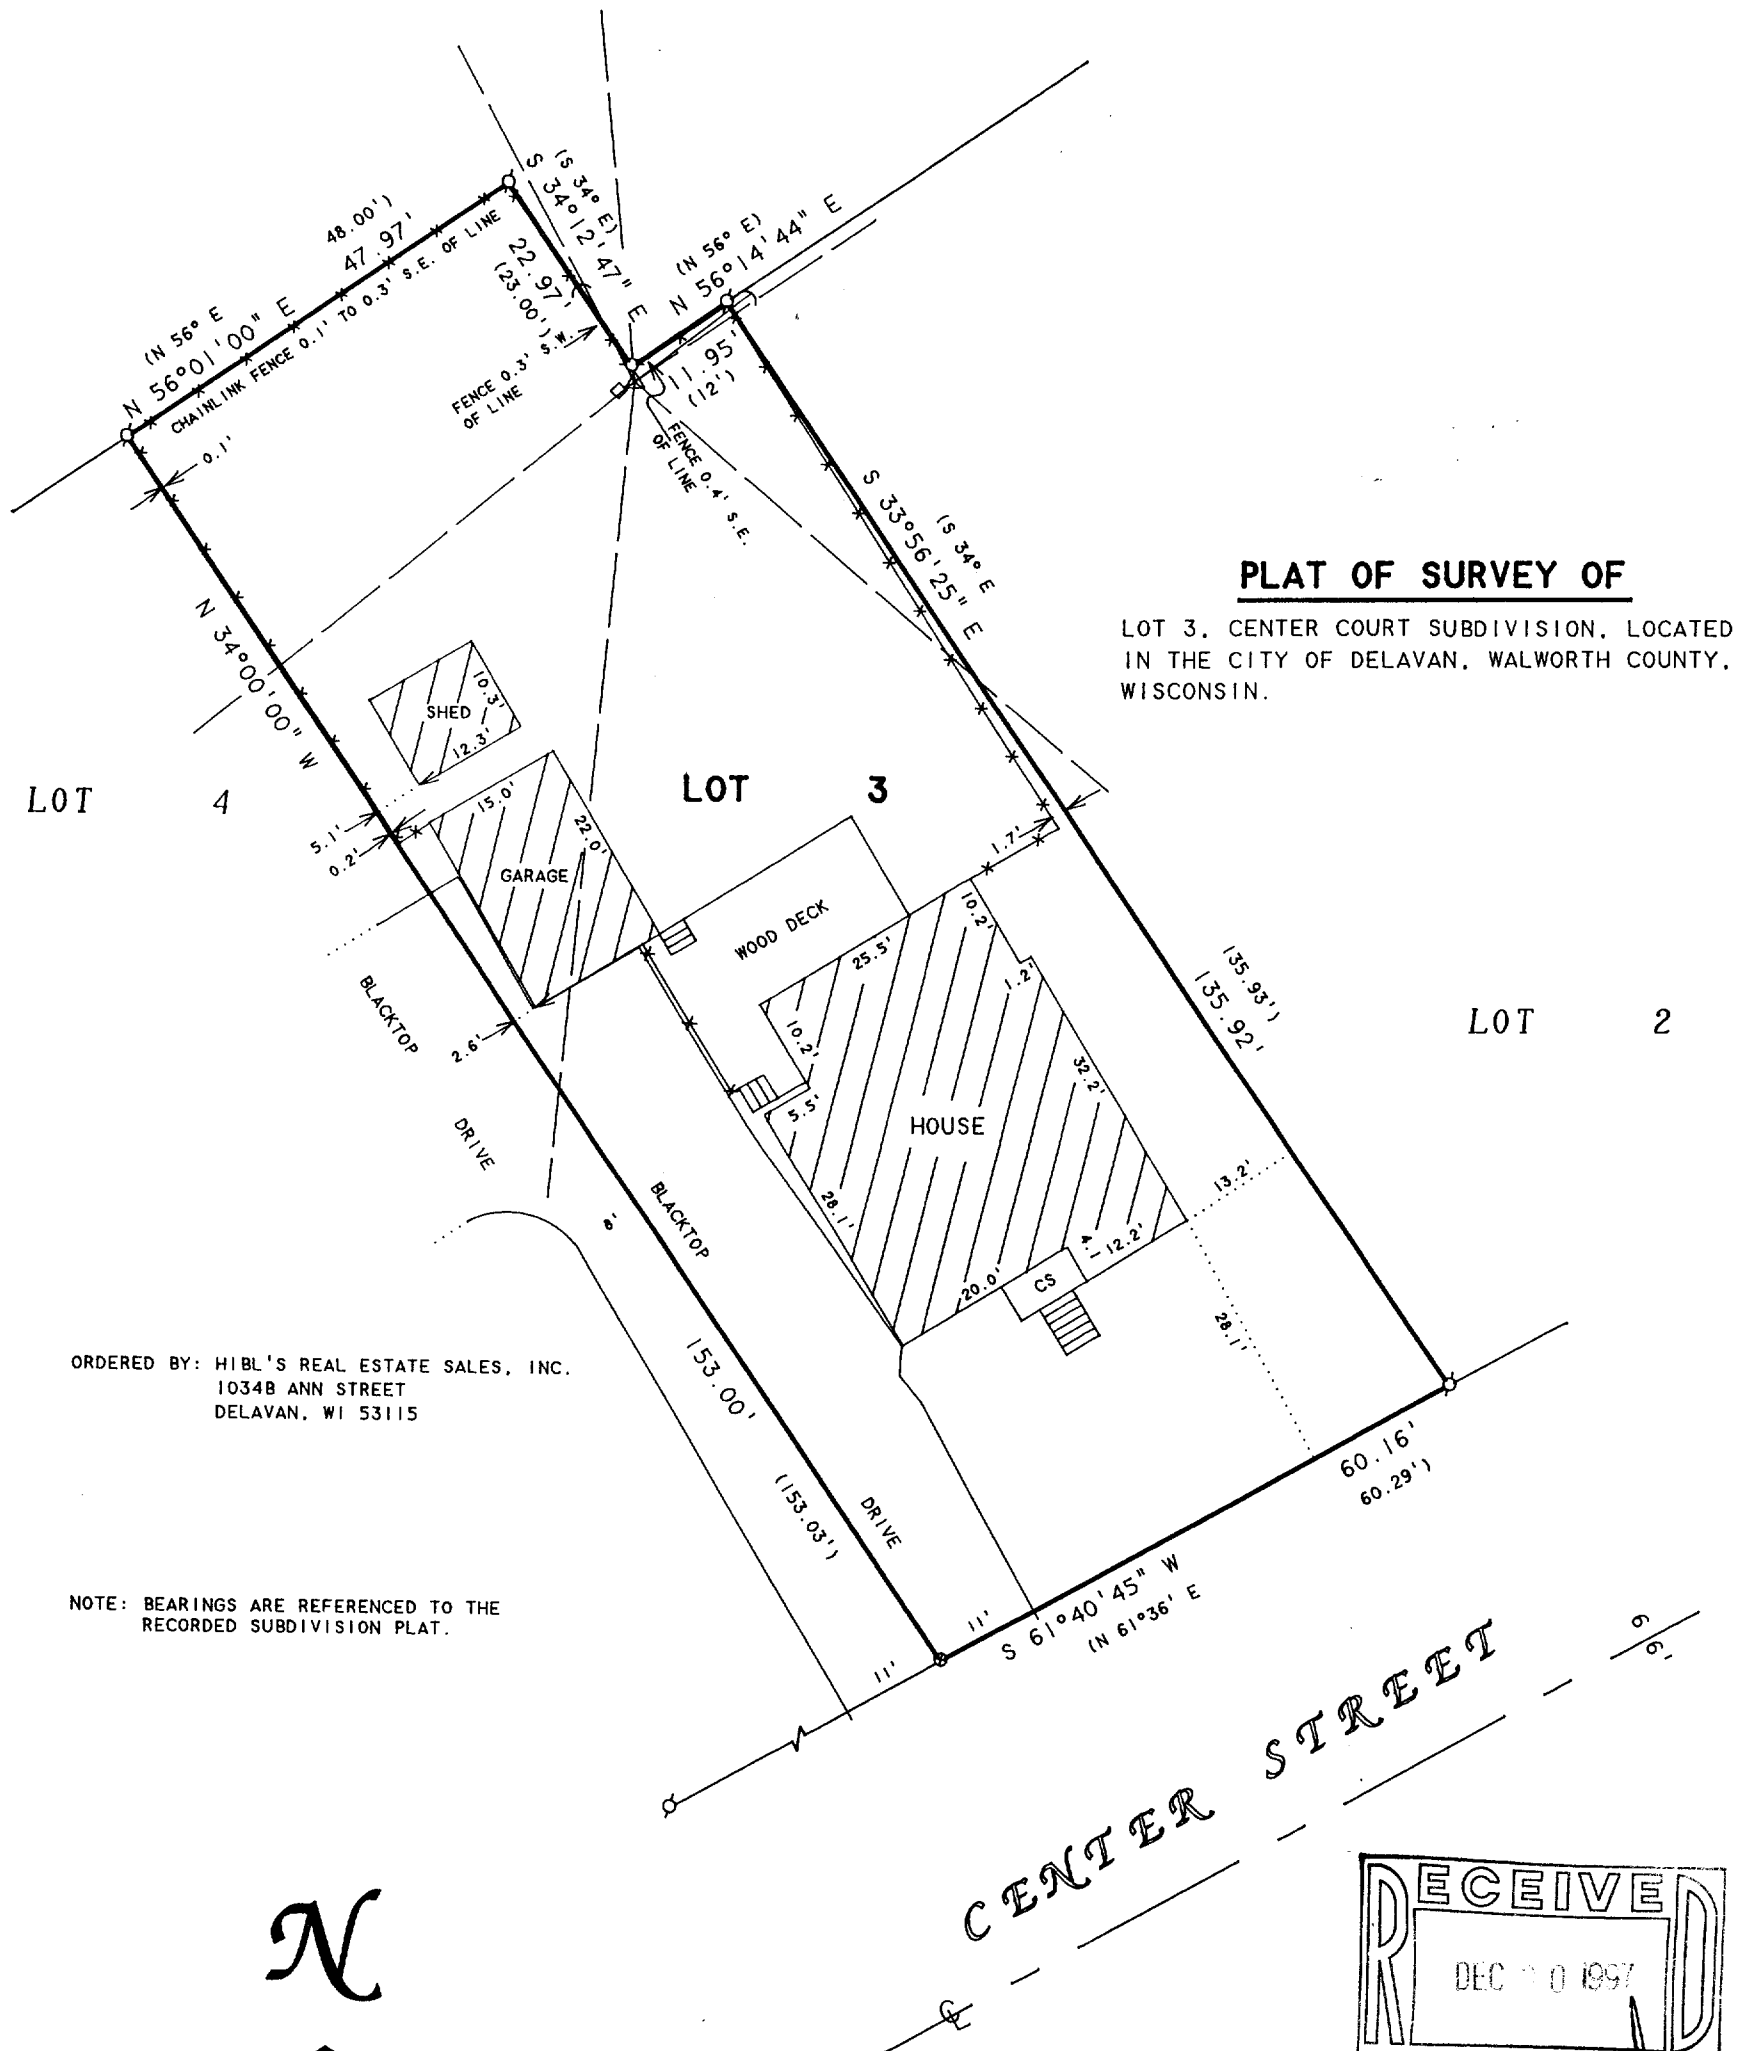

November 19, 1997

DATE JOB NUMBER - 97201
NOTE: THIS IS NOT A CERTIFIED COPY UNLESS SEALED.

002-1652
XC-3