


DUNHAM & RASMUSSEN
SURVEYING & ENGINEERING
DELAVER, WISCONSIN

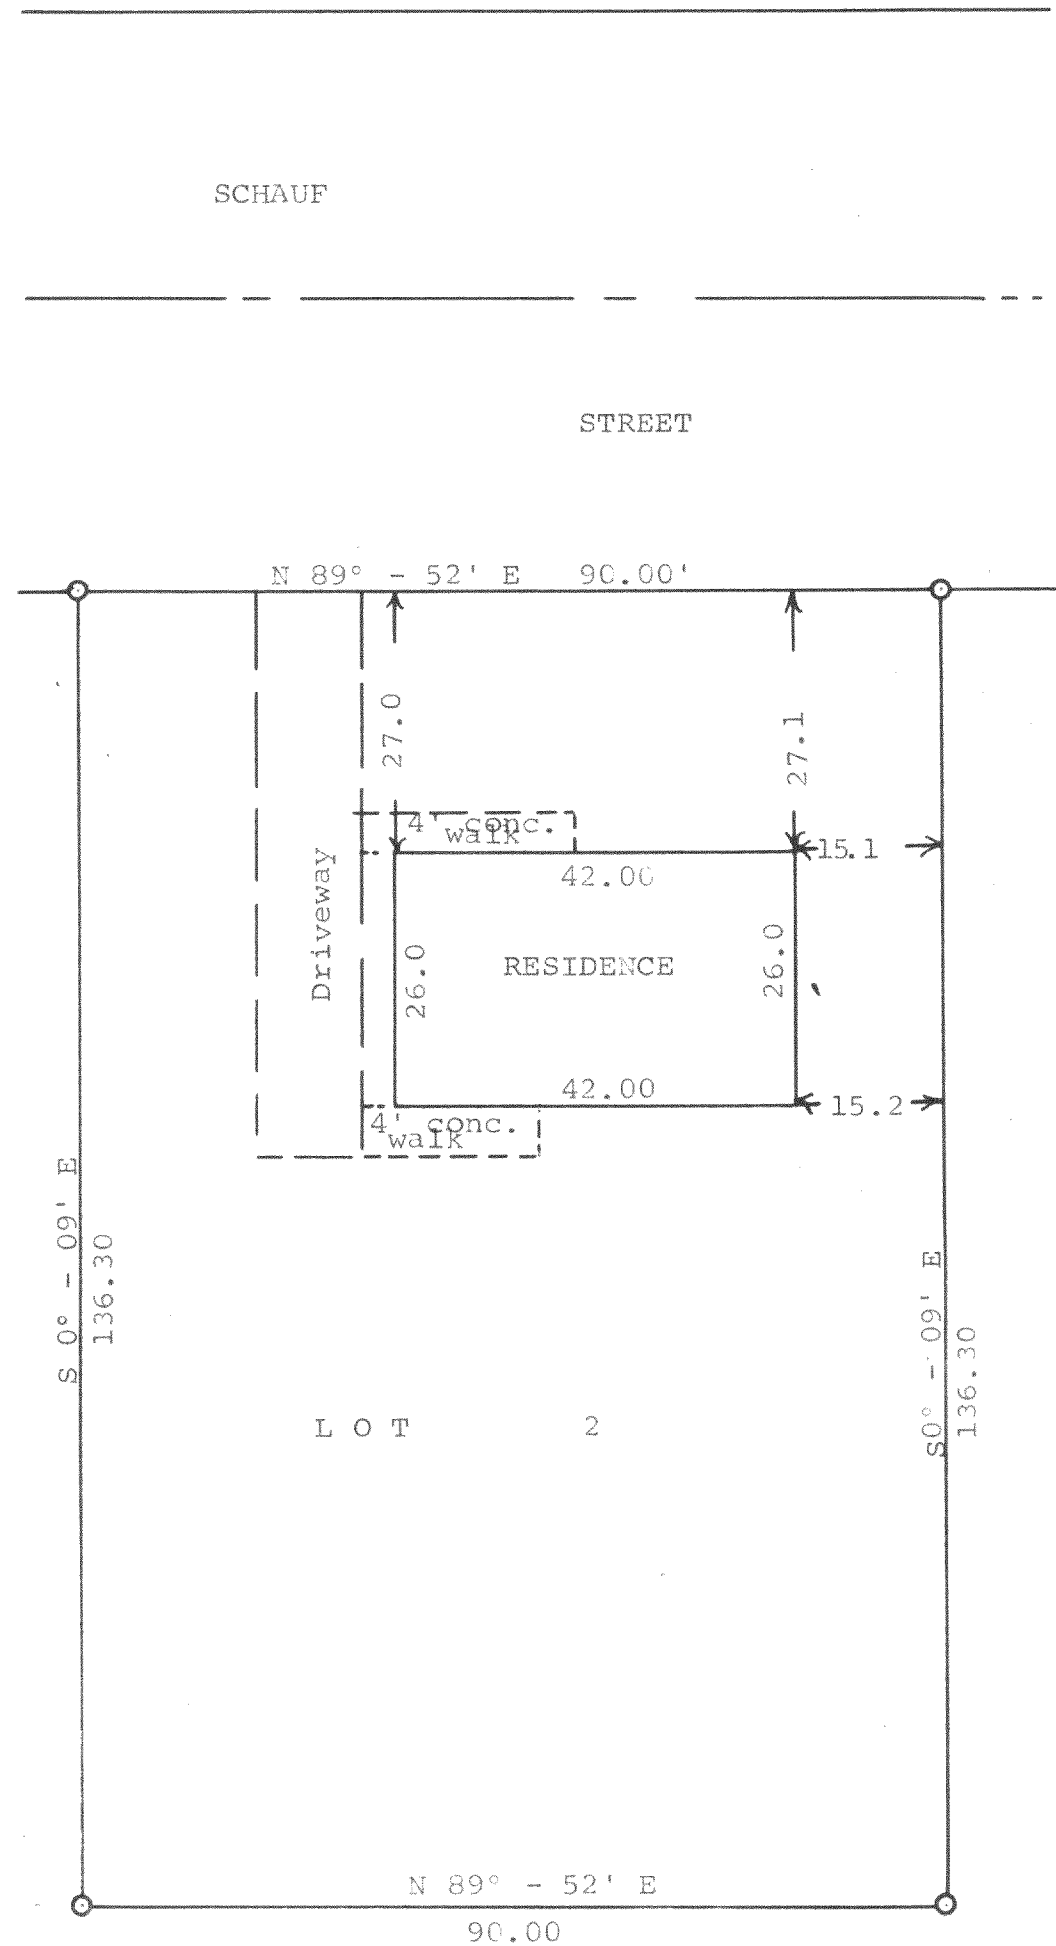

Scale-1"=20'
○ = Iron Pipe

STATE OF WISCONSIN) SS
WALWORTH COUNTY)
I, George T. Dunham, do hereby certify that I have surveyed
the property described as follows,
Lot 2 of Hilltop Subdivision located in the Southwest ¼ of
Section 18, T 2 N, R 16 E, City of Delavan, Walworth County,
Wisconsin
and that the plat shown above is a correct representation of the property
lines and of the improvements located thereon.
October 6, 1961

George T. Dunham
George T. Dunham, Surveyor