ABERNATHY and ASSOCIATES

Kenneth B. Abernathy Jr.

Wisconsin Registered Land Surveyor S-1594

Rt. 3, Box 273


Elkhorn, Wisconsin 53121 Phone: (414) 723-4260 (office)

(414) 723-4280 (Office) (414) 723-4813 (residence)

PLAT OF SURVEY

LOT 41, WHISPERING PINES SUBDIVISION, LOCATED IN THE SOUTHEAST 1/4 SECTION 13, TOWN 2 NORTH, RANGE 15 EAST, CITY OF DELAVAN, WALWORTH COUNTY, WISCONSIN.

ORDERED BY: SCHAUDER BUILDING, INC.
4115 HIGHWAY 51 NORTH
JANESVILLE, WISCONSIN
53545-9674

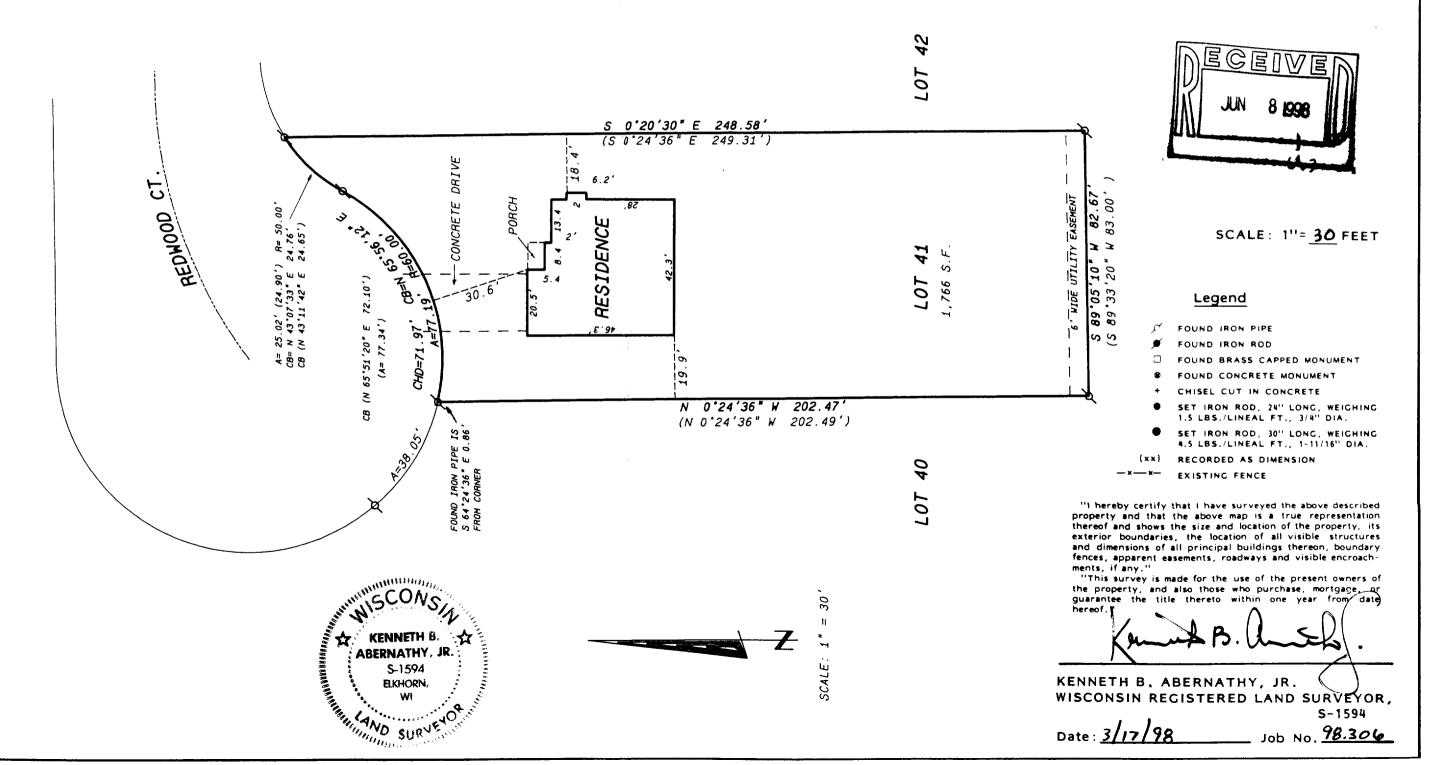

802-1712

XWP-41