
## **ABELL** SURVEYING & MAPPING

DELAVAN, WISCONSIN 53115 414-728-6737

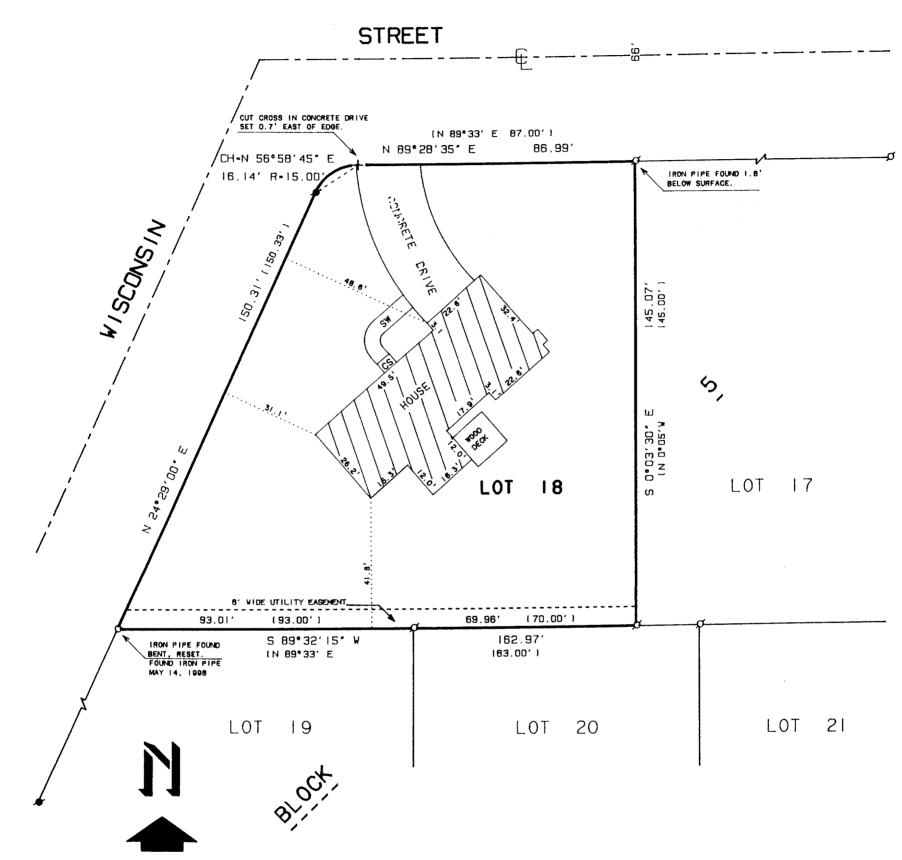

SCALE | "= 30" LEGEND

Ø - IRON PIPE FOUND

→ CONCRETE MONUMENT FOUND

O -IRON PIPE SET

+ -CUT CROSS IN CONCRETE SET

SW -SIDEWALK

CS -CONCRETE STOOP

( )-RECORDED AS

PLAT OF SURVEY OF

LOT 18, BLOCK 5, SPRINGS PARK SUBDIVISION ADDITION NO. I, LOCATED IN THE CITY OF DELAVAN, WALWORTH COUNTY, WISCONSIN.



NOTE: BEARINGS ARE REFERENCED TO THE RECORDED SUBDIVISION PLAT.

ORDERED BY: PROFESSIONAL REALTY 706 E. GENEVA ST. DELAVAN, WI. 53115

RECERTIFIED: MAY 14, 1998 ORDERED BY: KEEFE REAL ESTATE

1155 E. GENEVA ST. DELAVAN, WI 53115 I HEREBY CERTIFY THAT I HAVE SURVEYED THE ABOVE DESCRIBED PROPERTY AND THAT THE ABOVE MAP IS A TRUE REPRESENTATION THEREOF AND SHOWS THE SIZE AND LOCATION OF THE PROPERTY, ITS EXTERIOR BOUNDARIES, THE LOCATION OF ALL VISIBLE STRUCTURES AND DIMENSIONS OF ALL PRINCIPAL BUILDINGS THEREON. BOUNDARY FENCES. APPARENT EASEMENTS, ROADWAYS AND VISIBLE ENCROACHMENTS, IF ANY, TO THE BEST OF MY KNOWLEDGE AND BELIEF.

THIS SURVEY IS MADE FOR THE USE OF THE PRESENT OWNERS OF THE PROPERTY. AND ALSO THOSE WHO PURCHASE, MORTGAGE, OR GUARANTEE THE TITLE THERETO WITHIN ONE (1) YEAR

DAVID F. ABELL

WISCONSIN REGISTERED LAND SURVEYOR, S-1596

March 28, 1991 NOTE: THIS IS NOT A CERTIFIED COPY UNLESS SEALED.