
ABELL SURVEYING & MAPPING

1140 SEQUOIA STREET . DELAVAN. WISCONSIN 53115 414-728-6737

RACINE

STREET

66 FEET WIDE

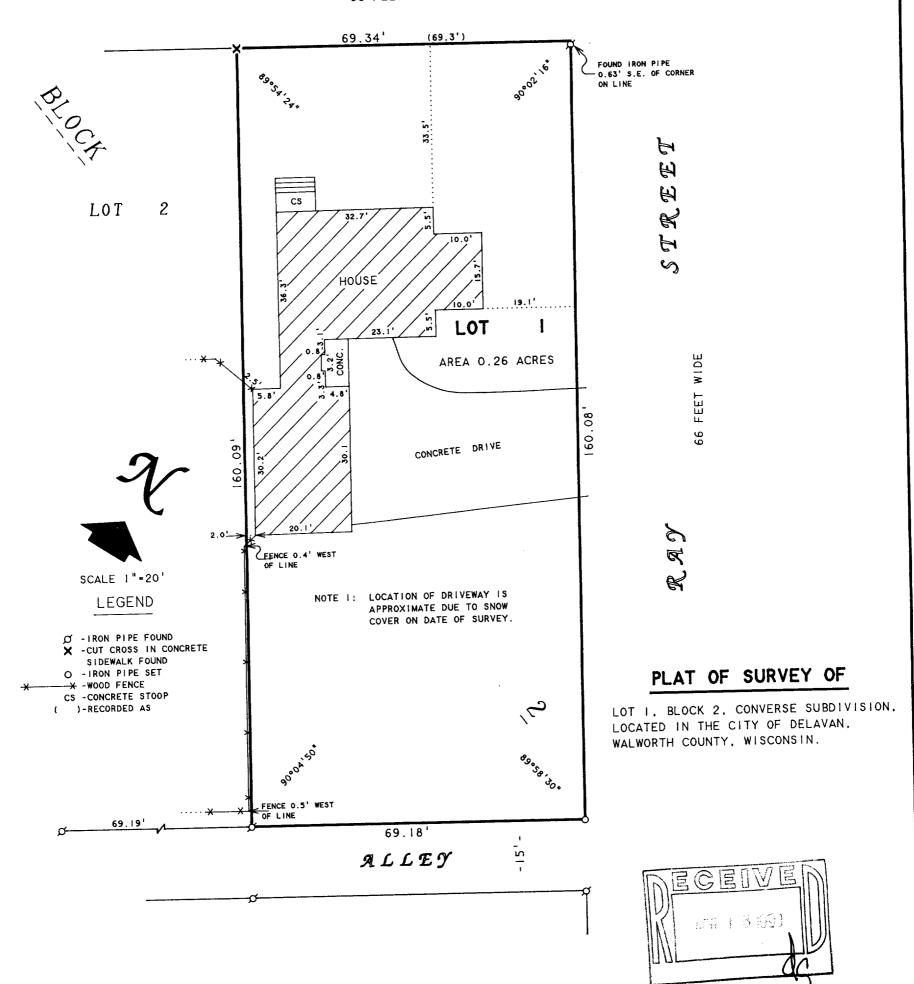

NOTE 2: DIMENSIONS USED FOR BLOCK 2 WERE TAKEN FROM CITY ENGINEERS RECORDS ON FILE AT CITY HALL (DELAVAN, WI.)

ORDERED BY: CENTURY 21-SKANDIA REALTY

822 E. GENEVA STREET DELAVAN, WI 53115

I HEREBY CERTIFY THAT I HAVE SURVEYED THE ABOVE DESCRIBED PROPERTY AND THAT THE ABOVE MAP IS A TRUE REPRESENTATION THEREOF AND SHOWS THE SIZE AND LOCATION OF THE PROPERTY. ITS EXTERIOR BOUNDARIES. THE LOCATION OF ALL VISIBLE STRUCTURES AND DIMENSIONS OF ALL PRINCIPAL BUILDINGS THEREON, BOUNDARY FENCES, APPARENT EASEMENTS. ROADWAYS AND VISIBLE ENCROACHMENTS. IF ANY, TO THE BEST OF MY KNOWLEDGE AND BELIEF.

THIS SURVEY IS MADE FOR THE USE OF THE PRESENT OWNERS OF THE PROPERTY. AND ALSO THOSE WHO PURCHASE. MORTGAGE. OR GUARANTEE THE TITLE THERETO WITHIN ONE (I) YEAR FROM DATE HEREON.

DAVID F. ABELL WISCONSIN REGISTERED LAND SURVEYOR, S-1596

January 25, 1999

DATE JOB NUMBER - 99002 NOTE: THIS IS NOT A CERTIFIED COPY UNLESS SEALED.