
## ABELL

## SURVEYING & MAPPING

DELAVAN, WISCONSIN 53115 414-728-6737

**WISCONSIN** 

STREET

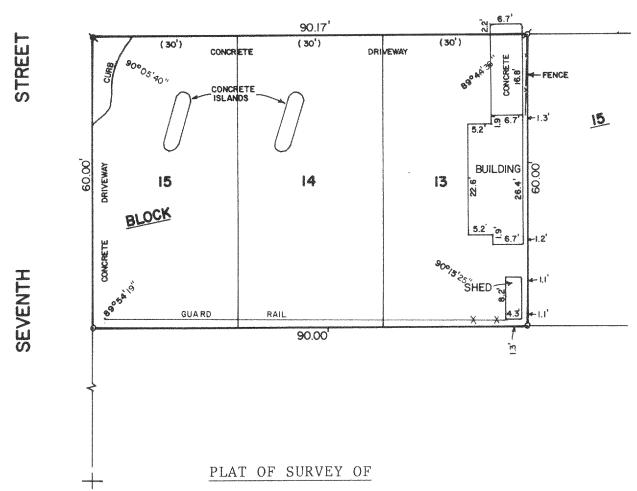


LOTS 13-15, BLOCK 15, PASSAGE, ARAM & DOWNIE ADDITION, CITY OF DELAVAN, WALWORTH COUNTY, WISCONSIN.

ORDERED BY:

JERRY DeFRANCISO c/o DUANE MATRANGE 20 ORCHARD ST. WILLIAMS BAY, WI.

REVISED AND RECERTIFIED APRIL 19, 1999 ORDERED BY: CITY OF DELAVAN

RDERED BY: CITY OF DELAVAN 123 S. 2nd STREET DELAVAN, WI 53115

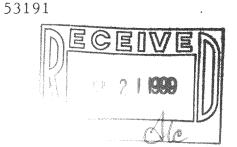



SCALE - 1"=20'

LEGEND

ø − IRON PIPE FOUND

 IRON ROD IN CONCRETE FOUND

+- CUT CROSS IN CONCRETE FOUND

( )- RECORDED AS

• - IRON ROD SET, FOUND 4/16/99

I HEREBY CERTIFY THAT I HAVE SURVEYED THE ABOVE DESCRIBED PROPERTY AND THAT THE ABOVE MAP IS A TRUE REPRESENTATION THEREOF AND SHOWS THE SIZE AND LOCATION OF THE PROPERTY, ITS EXTERIOR BOUNDARIES. THE LOCATION OF ALL VISIBLE STRUCTURES AND DIMENSIONS OF ALL PRINCIPAL BUILDINGS THEREON, BOUNDARY FENCES, APPARENT EASEMENTS, ROADWAYS AND VISIBLE ENCROACHMENTS, IF ANY, TO THE BEST OF MY KNOWLEDGE AND BELIEF.

THIS SURVEY IS MADE FOR THE USE OF THE PRESENT OWNERS OF THE PROPERTY. AND ALSO THOSE WHO PURCHASE, MORTGAGE. OR GUARANTEE THE TITLE THERETO WITHIN ONE (I) YEAR FROM DATE HEREON.

David 7. abell
DAVID F. ABELL

WISCONSIN REGISTERED LAND SURVEYOR, S-1596

<u> Opril 6, 198</u>
DATE JO

JOB NUMBER - 88047 NOTE: THIS IS NOT A CERTIFIED COPY UNLESS SEALED.

XP-188

002-1796